


# T.7S. R.5W. W.M.

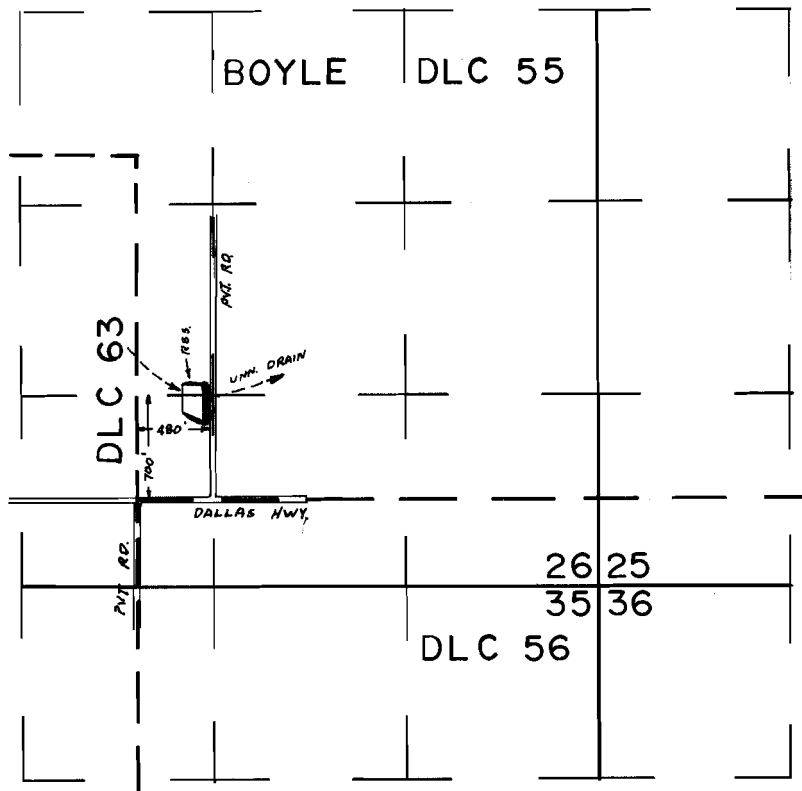

## FINAL PROOF SURVEY UNDER

R-48613                      R-5899  
Application No. 48614    Permit No. 36468  
IN NAME OF

OTTO BIER

Surveyed JUN 11 1974, by LH NUNN