


T.7S. R.5W. W.M.

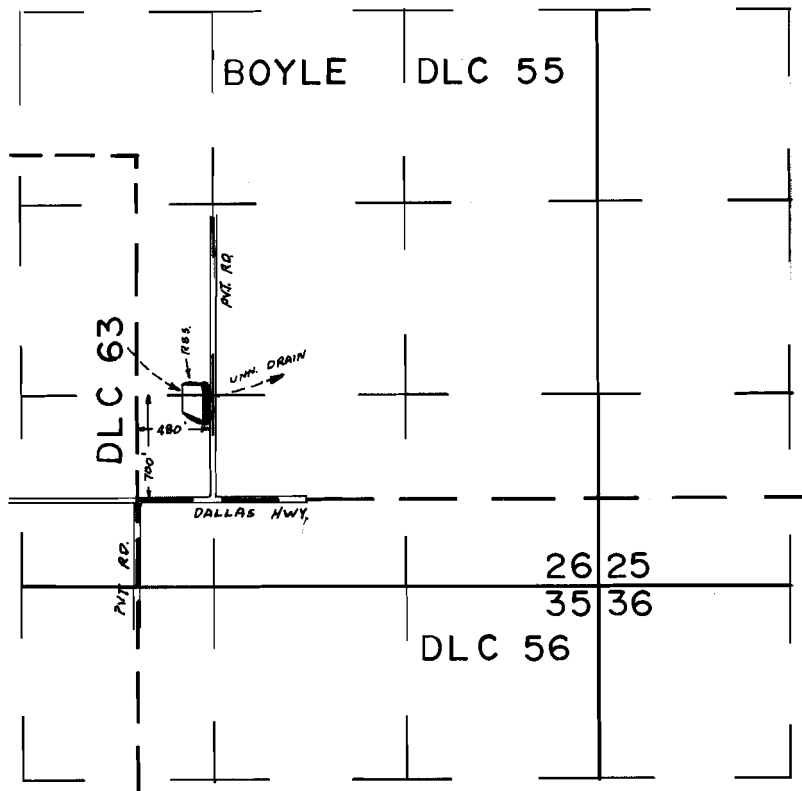

FINAL PROOF SURVEY
UNDER

R-48613

R-5899

Application No. 48614 Permit No. 36468

IN NAME OF

OTTO BIER

Surveyed JUN 11 1974, by LH NUNN