


T.6S. R.7W. W.M.

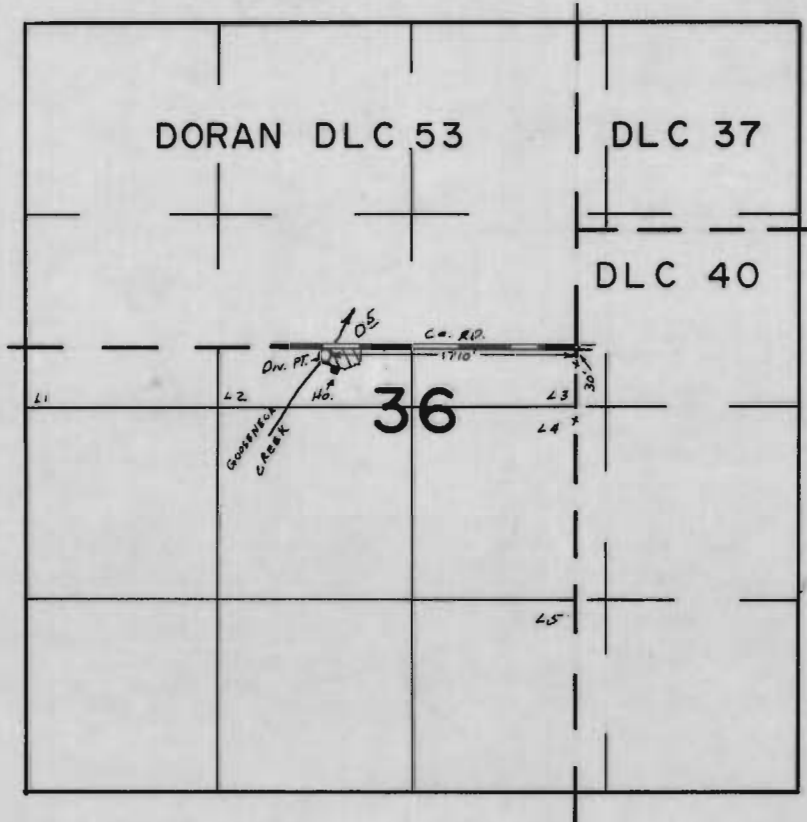

FINAL PROOF SURVEY
UNDER

Application No. 49457 Permit No. 37047
IN NAME OF

RICHARD M. STEARNS

Surveyed JUN 14 1974, by LH NUNN