


T.6S. R.6W. W.M.

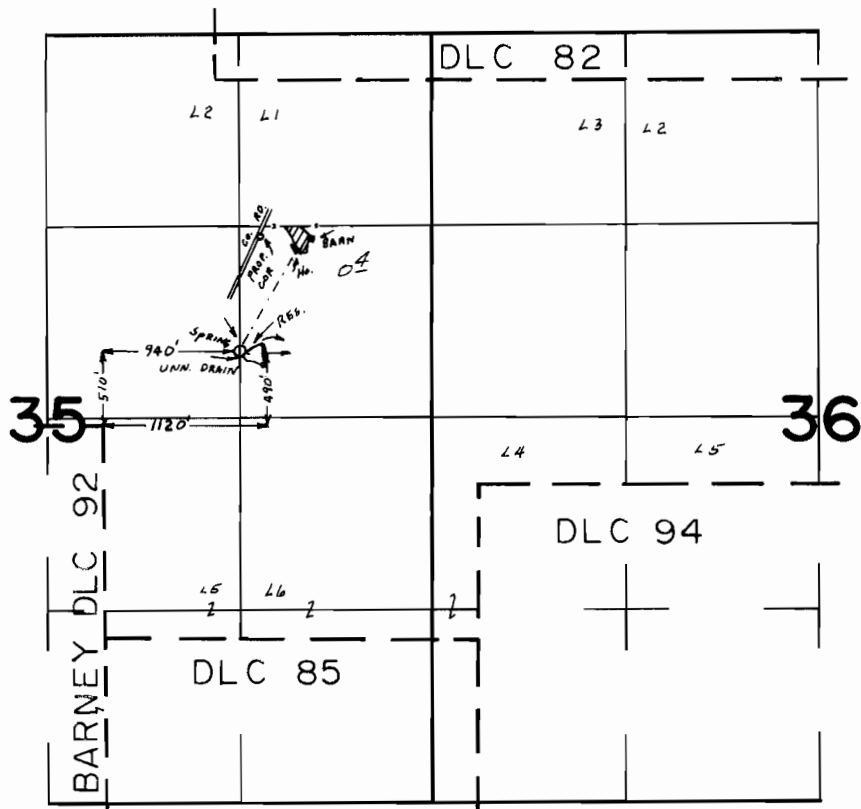

FINAL PROOF SURVEY UNDER

R-49770 R-6046
Application No. 49771 Permit No. 37263
IN NAME OF

WAYNE L. JACKSON

Surveyed JUN 13 1974, by LH NUNN