


G-4337
42860

T.4N., R.28E., W.M.

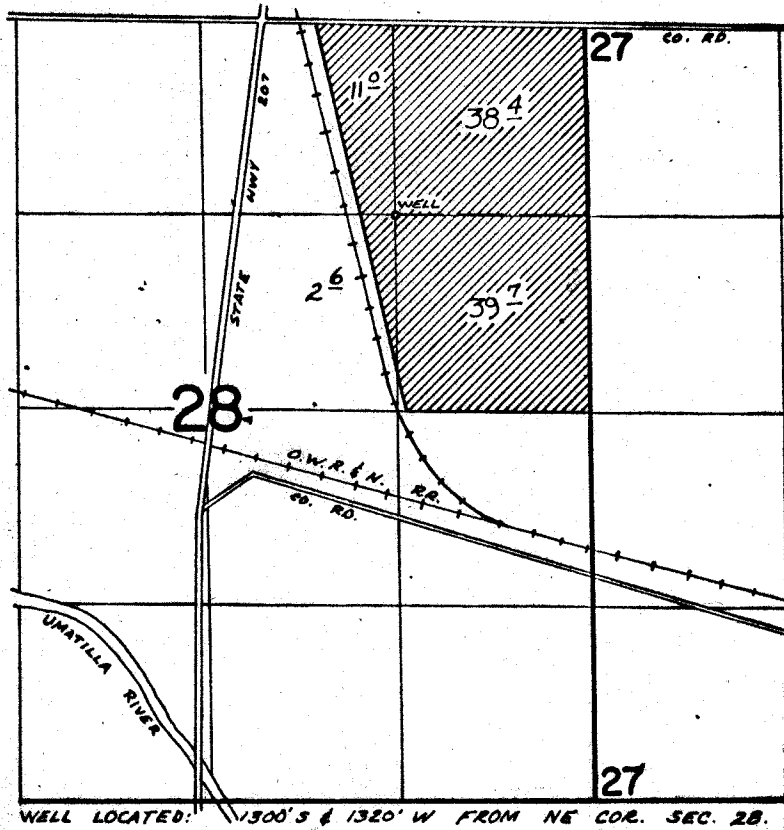

FINAL PROOF SURVEY UNDER

Application No. G-4613 Permit No. G-4337
IN NAME OF

SANDRA SHARP

Surveyed April 16 1974, by David Norby