


T.18&amp;2N. R.14E. W.M.

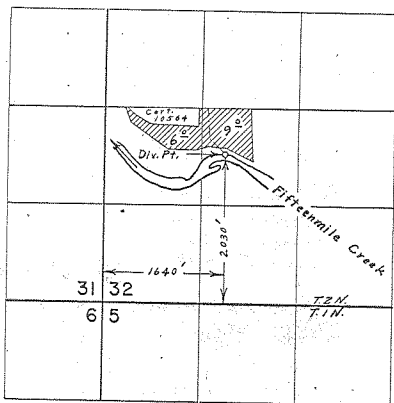

**FINAL PROOF SURVEY**  
UNDER

Application No. 46317... Permit No. 34606  
IN NAME OF

**FRED B. HOVEY**

Surveyed April 24, 1974, by David Norky.