


# T.2 S. R.4 W. W.M.

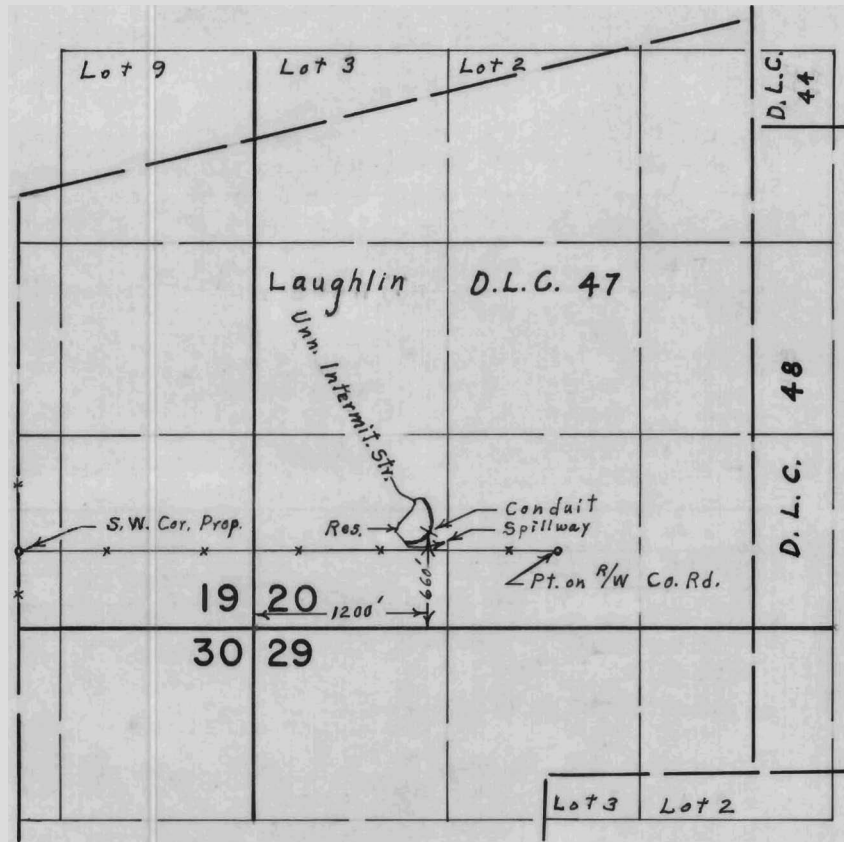

## FINAL PROOF SURVEY UNDER

Application No. R-51085 Permit No. R-6023  
IN NAME OF

**ARNOLD EIDSMOE**

Surveyed May 29, 1974, by L. E. Gould