


T. 4 S. R. 5 W. W.M.

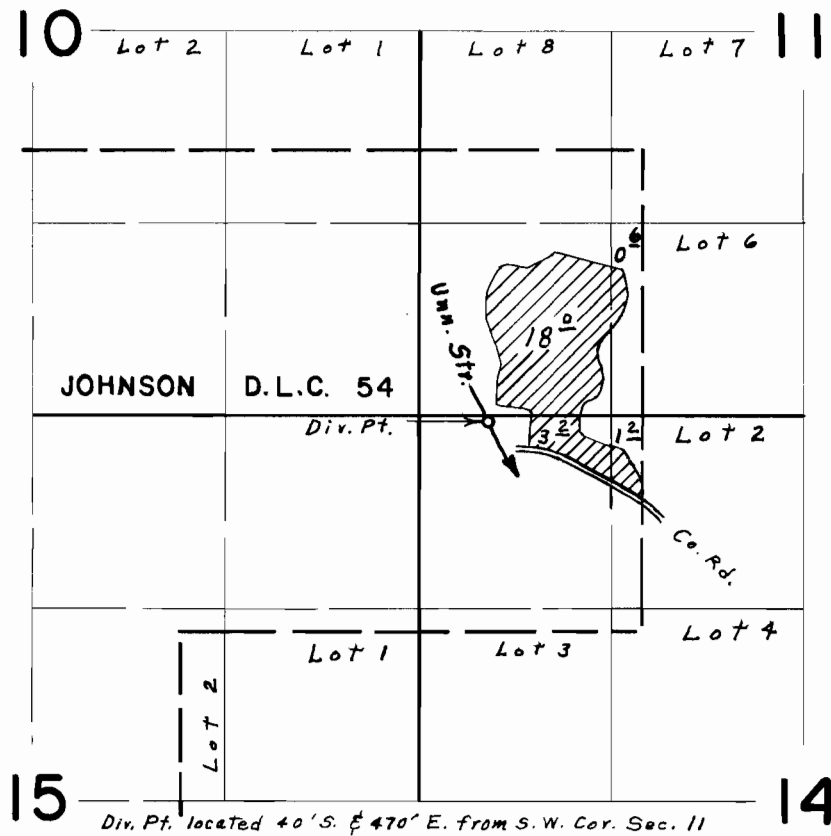

FINAL PROOF SURVEY UNDER

Application No. 38389 Permit No. 28604
IN NAME OF

LLOYD E. MORSE

Surveyed Sept. 26, 1974, by L. E. Gould