


T.4 S. R.5 W. W.M.

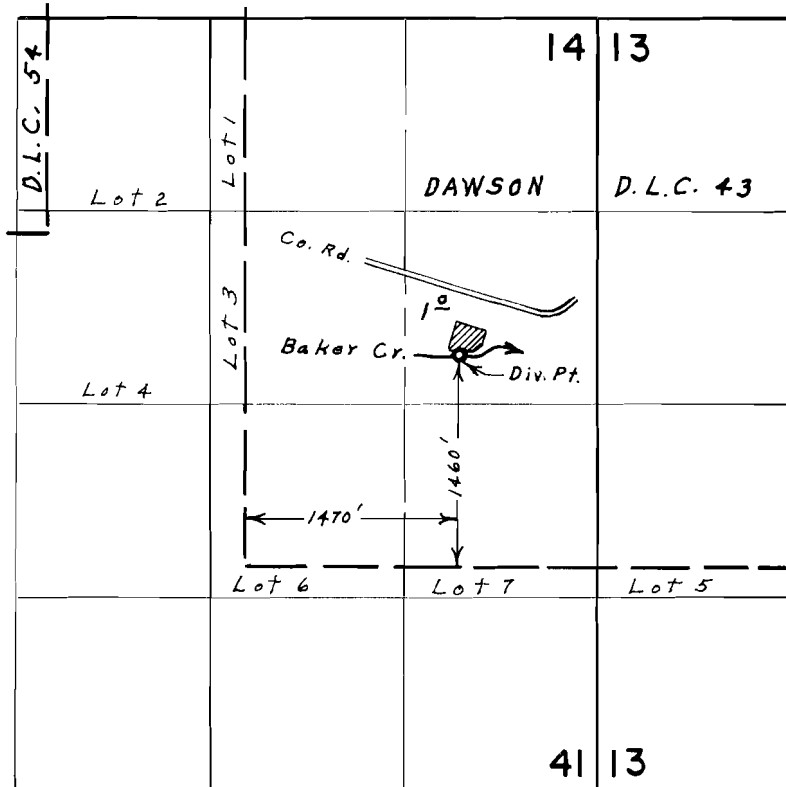

FINAL PROOF SURVEY UNDER

Application No. 46333 Permit No. 34669
IN NAME OF

KURT NOWAG

Surveyed May 31, 1974, by L. E. Gould