


T.3 S. R.5 W. W.M.

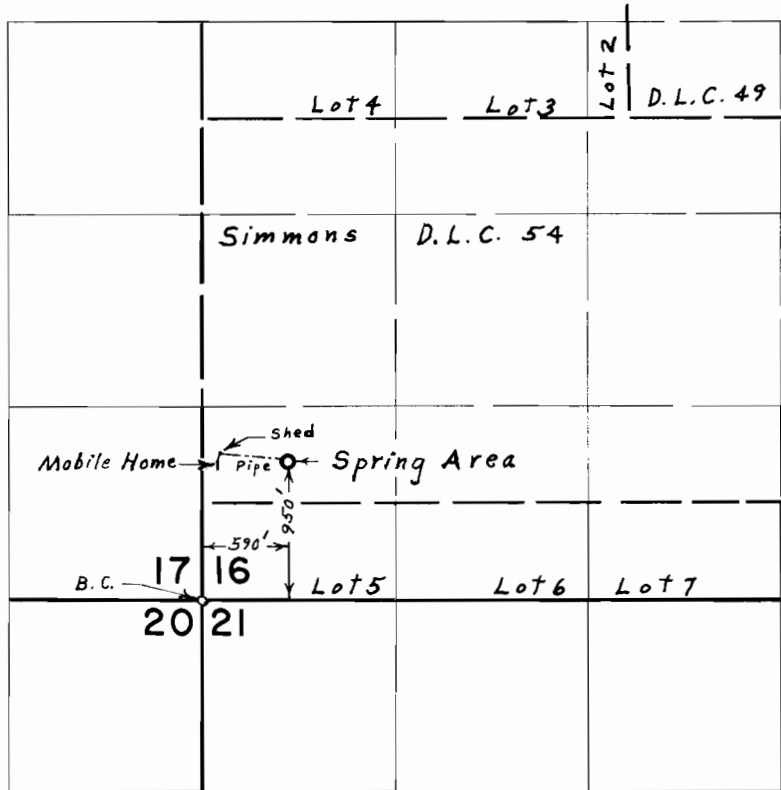

FINAL PROOF SURVEY UNDER

Application No. 48251 Permit No. 36654
IN NAME OF

PAUL B. SLOAN

Surveyed May 29, 1974, by L. E. Gould