


T.40S.R.3W.W.M.

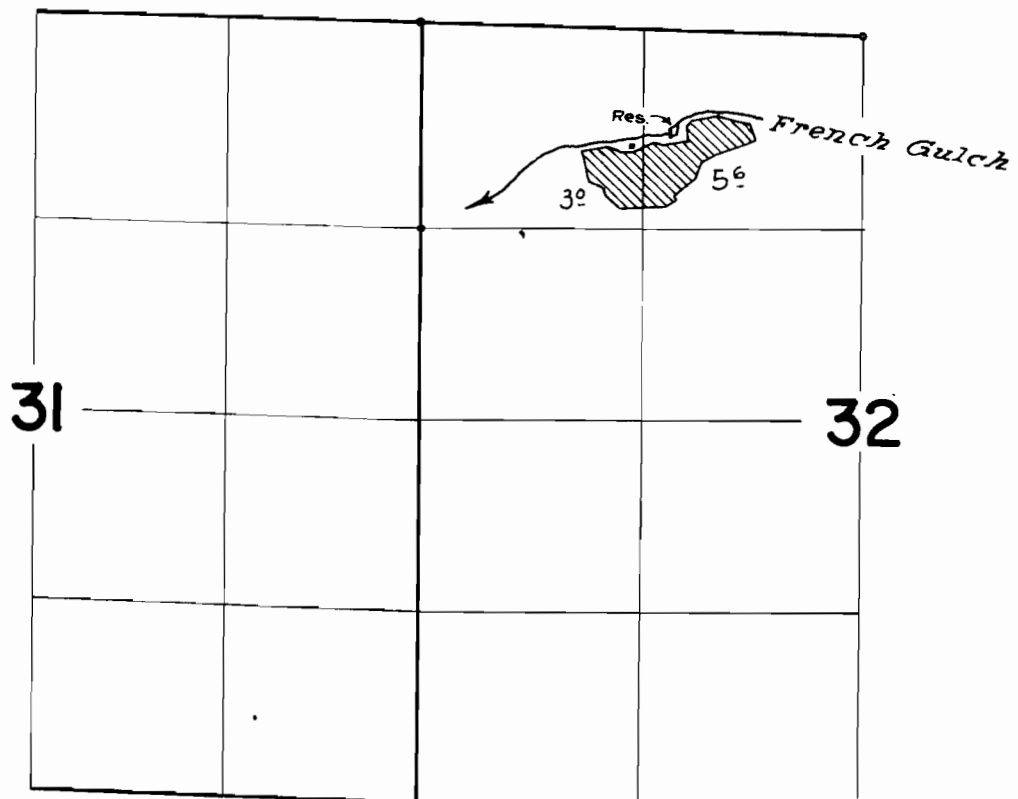

FINAL PROOF SURVEY
UNDER

R-28155 R-1484
Application No. 28156 Permit No. 22159
IN NAME OF

JAMES L. ALLEN by BERT HARR

Surveyed April 20 1961, by *R. Jackson*