


T.12S. R.11W. W.M.

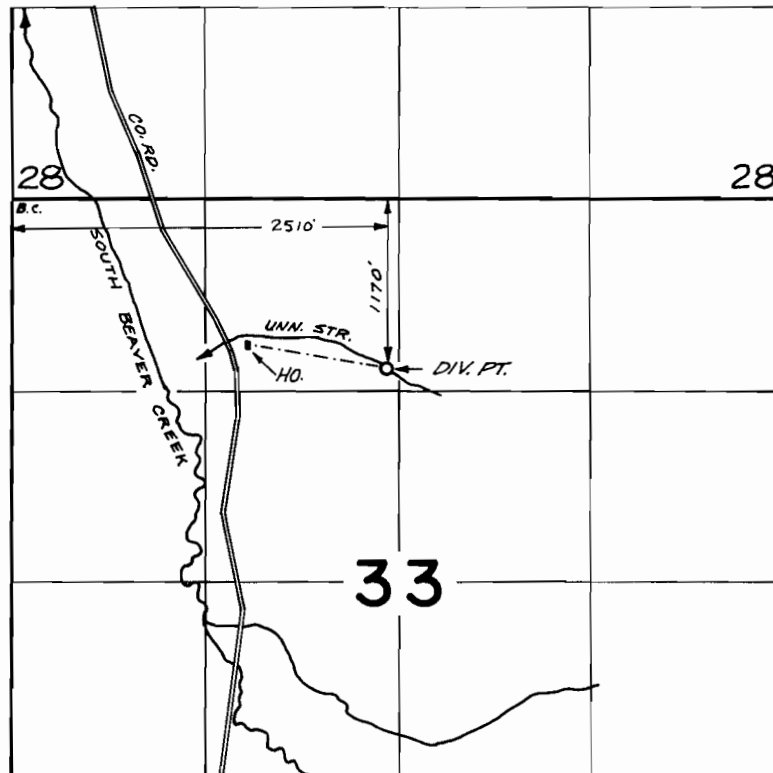

FINAL PROOF SURVEY
UNDER

Application No. 42676 Permit No. 31892
IN NAME OF

MRS. J.E. GATENS

Surveyed AUG 21 1974, by D. NORBY