


T.14S., R.5W., W.M.

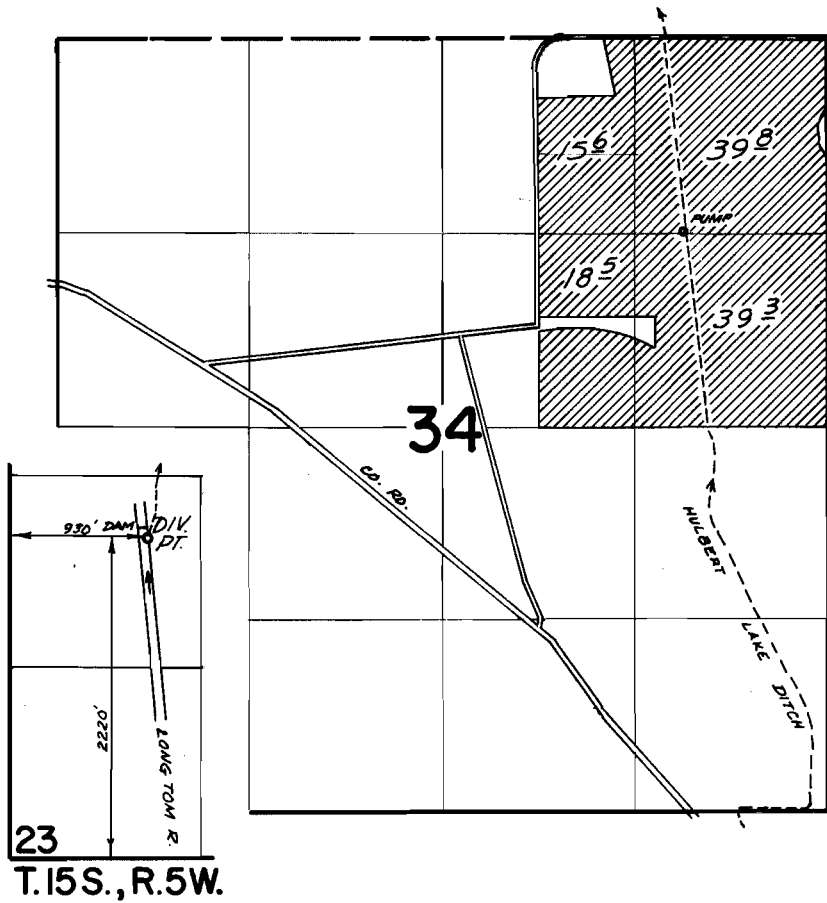

FINAL PROOF SURVEY
UNDER

Application No. 53832 44584 Permit No. 40182 33371
IN NAME OF

HOWARD SCHIERHOLZ

Surveyed June 8 1973 by D. Noeby
OCT 5 1976 C.R. KING