


# T.10S. R.3&4W. W.M.

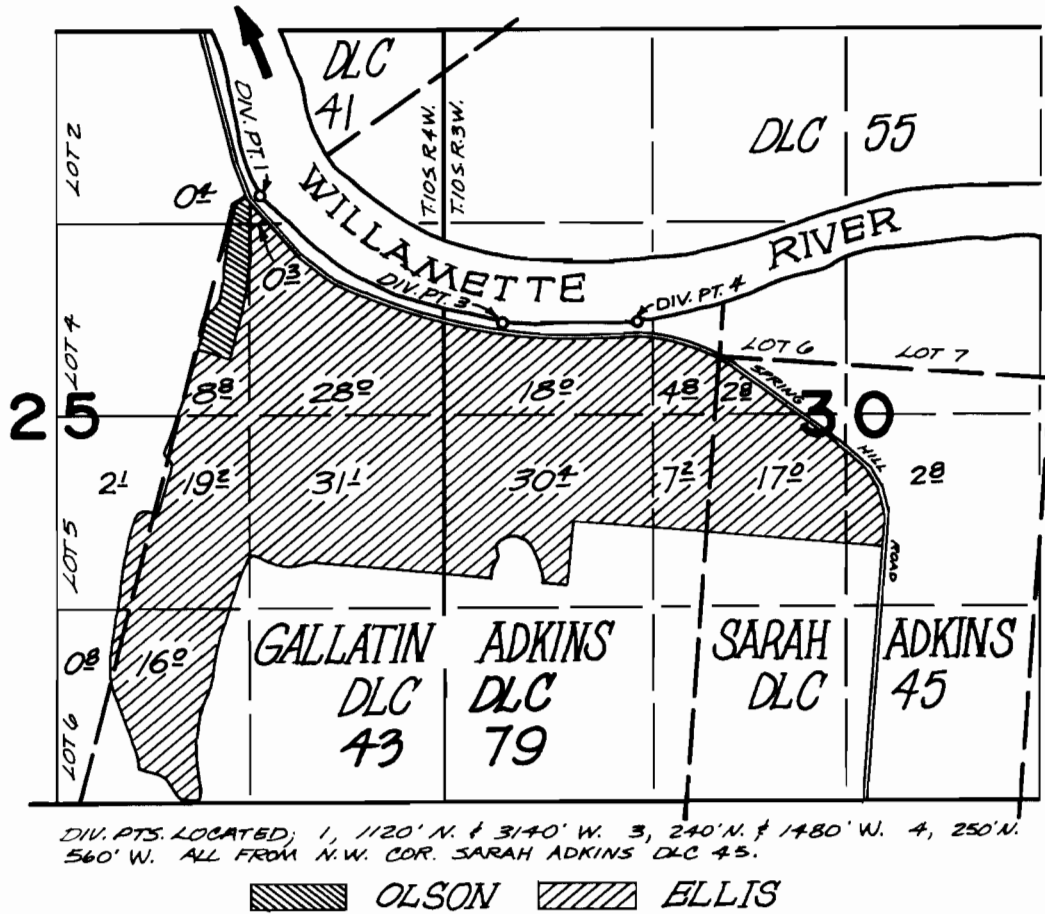

## FINAL PROOF SURVEY UNDER

Application No. 47888 Permit No. 35078  
 IN NAME OF  
**BEN & HAZEL O. ELLIS, PHILLIP D.**  
**OLSON & MARVIN W. & BERNADETTE OLSON**  
 Surveyed JULY 3 1974, by L.M. TOLL.....