


T.2S. R.4E. W.M.

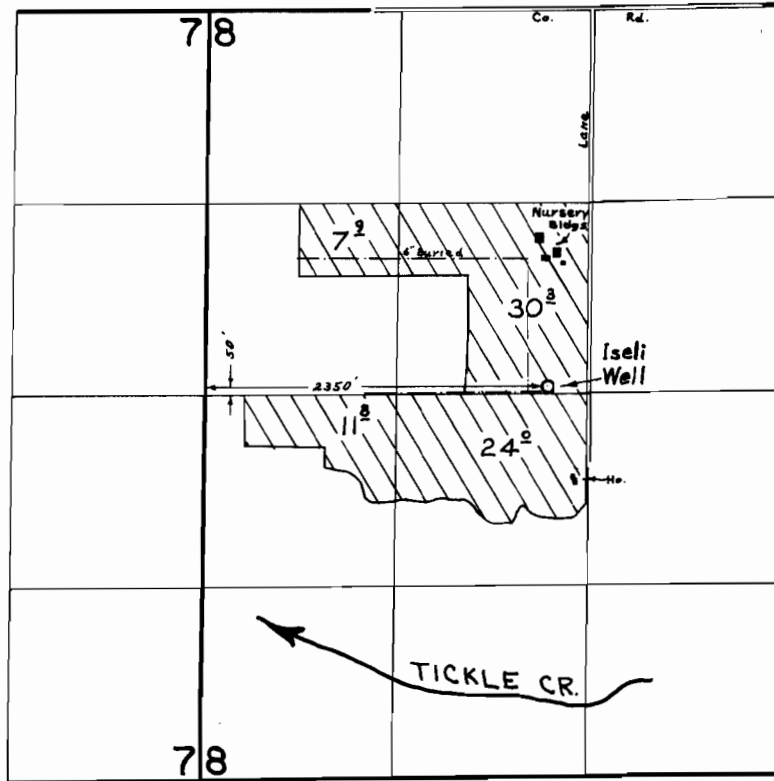

FINAL PROOF SURVEY
UNDER

Application No. G-2629 Permit No. G-2439
IN NAME OF

WERNER W. & GERMAINE ISELI

Surveyed NOV. 8, 1974, by L. E. GOULD