


T.2S. R.I.E. W.M.

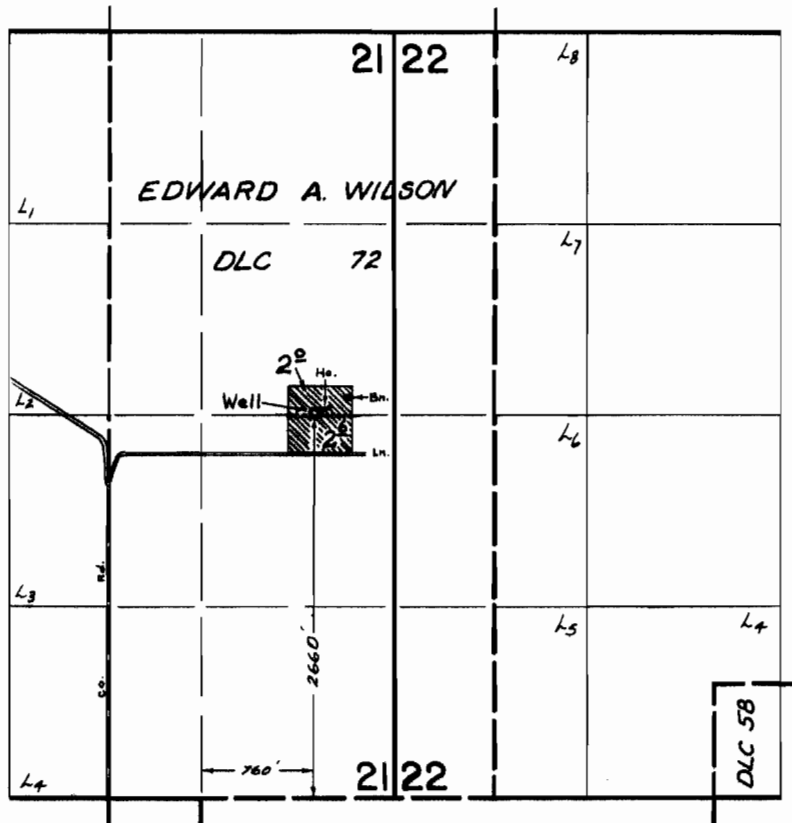

FINAL PROOF SURVEY UNDER

Application No. G-5019 Permit No. G-4728
IN NAME OF

C. P. DAVENPORT

Surveyed SEPT. 6, 1974, by L. E. GOULD