


T.4S., R.1E., W.M.

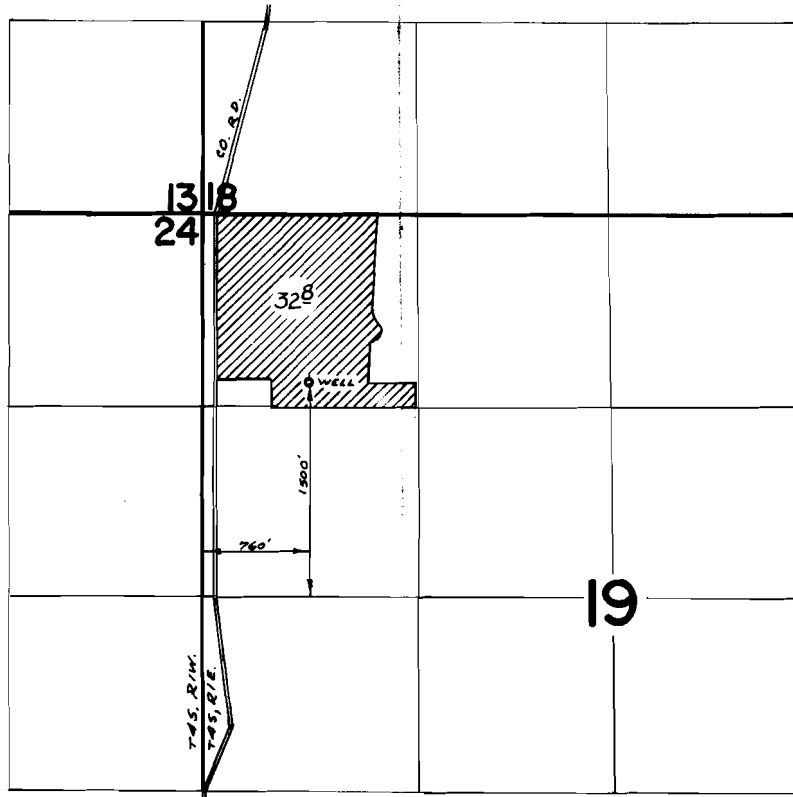

FINAL PROOF SURVEY UNDER

Application No. G-5151 Permit No. G-4838
IN NAME OF

PAUL C. BERGER

Surveyed Sept. 17 1974, by D. Dorby