


T.2S. R.4E. W.M.

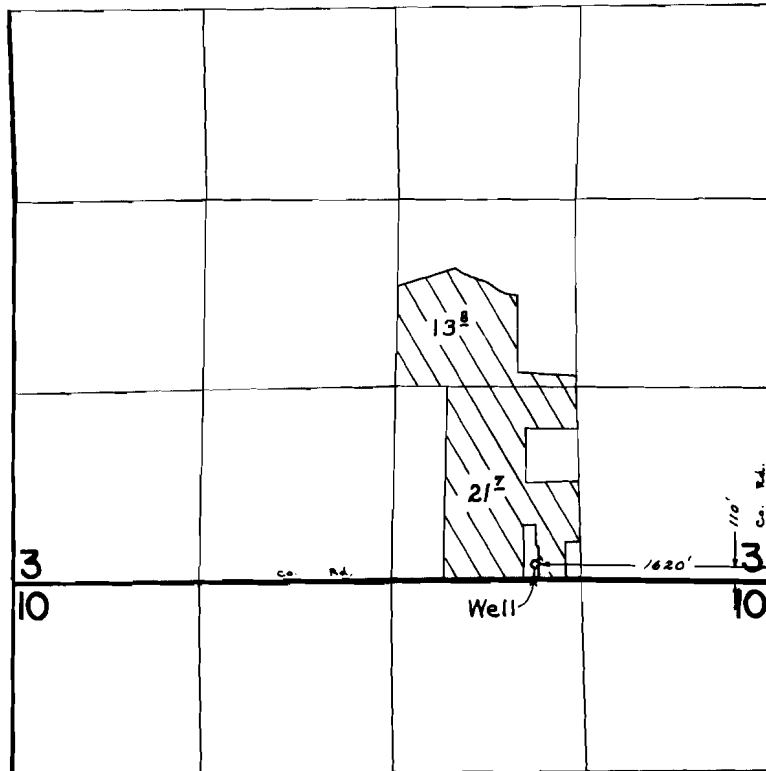

FINAL PROOF SURVEY UNDER

Application No. G-5131 Permit No. G-4867
IN NAME OF

WILHELM HECKEL

Surveyed NOV. 7 1974, by L. E. GOULD