


# T.4S. R.I.E. W.M.

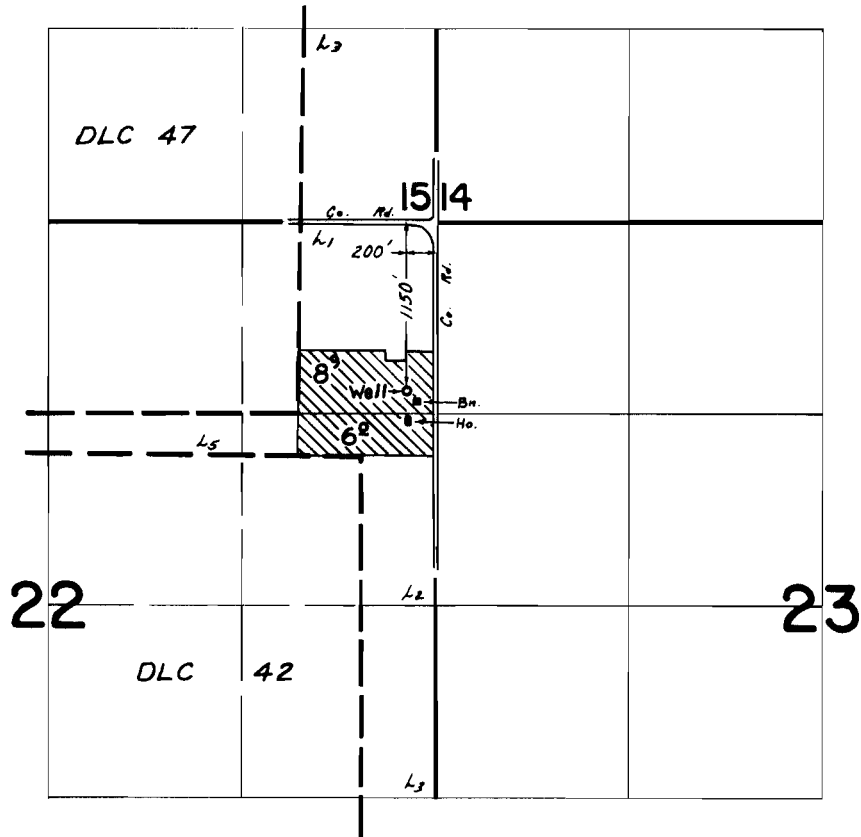

## FINAL PROOF SURVEY UNDER

Application No. G-6016 Permit No. G-5177  
IN NAME OF

TERRY KOCH

Surveyed JULY 19, 1974, by L. E. GOULD