


T.2S. R.3E. W.M.

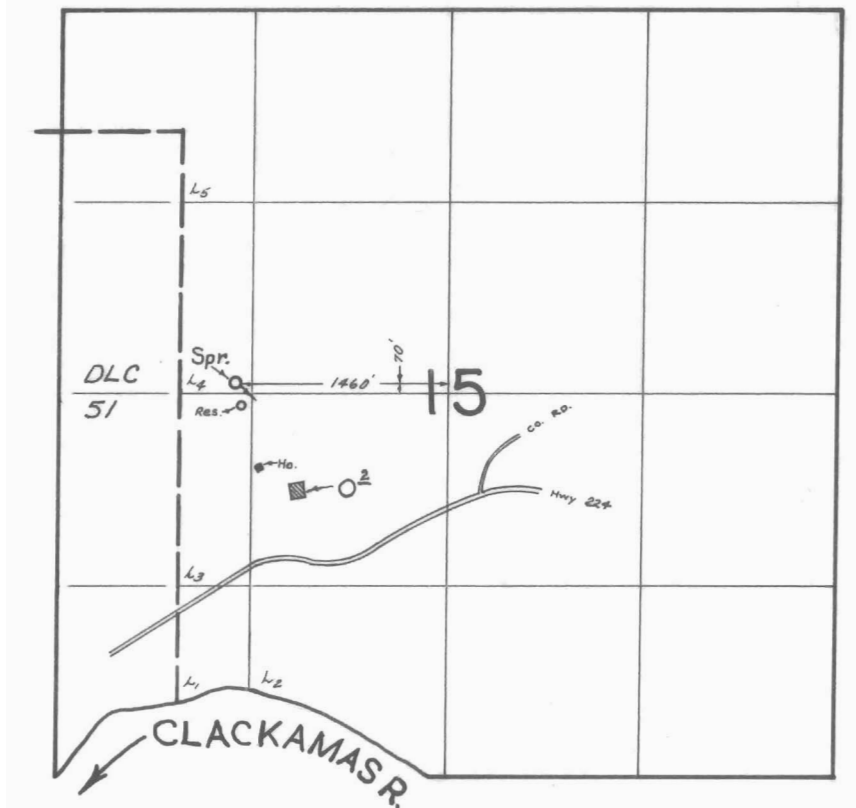

**FINAL PROOF SURVEY**  
UNDER

Application No. 46821 Permit No. 35013  
IN NAME OF

VERNON FLOREN

Surveyed OCT. 2, 1974, by L.E. GOULD