


T.2S. R.4E. W.M.

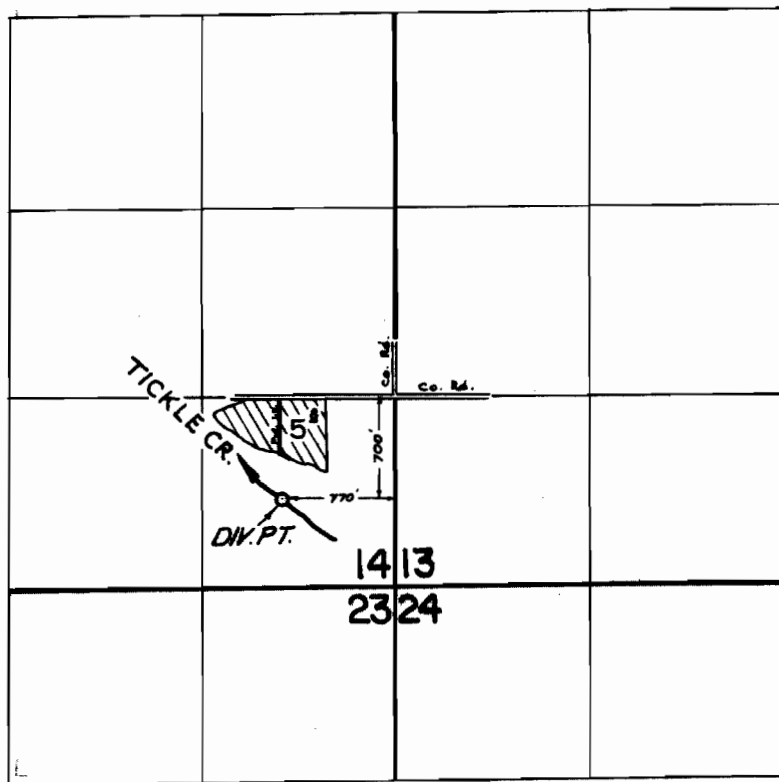

FINAL PROOF SURVEY
UNDER

Application No. 47245 Permit No. 35388
IN NAME OF

MYRON D. TUPPER

Surveyed NOV. 8, 1974, by L. E. GOULD