


T.4S., R.2E., W.M.

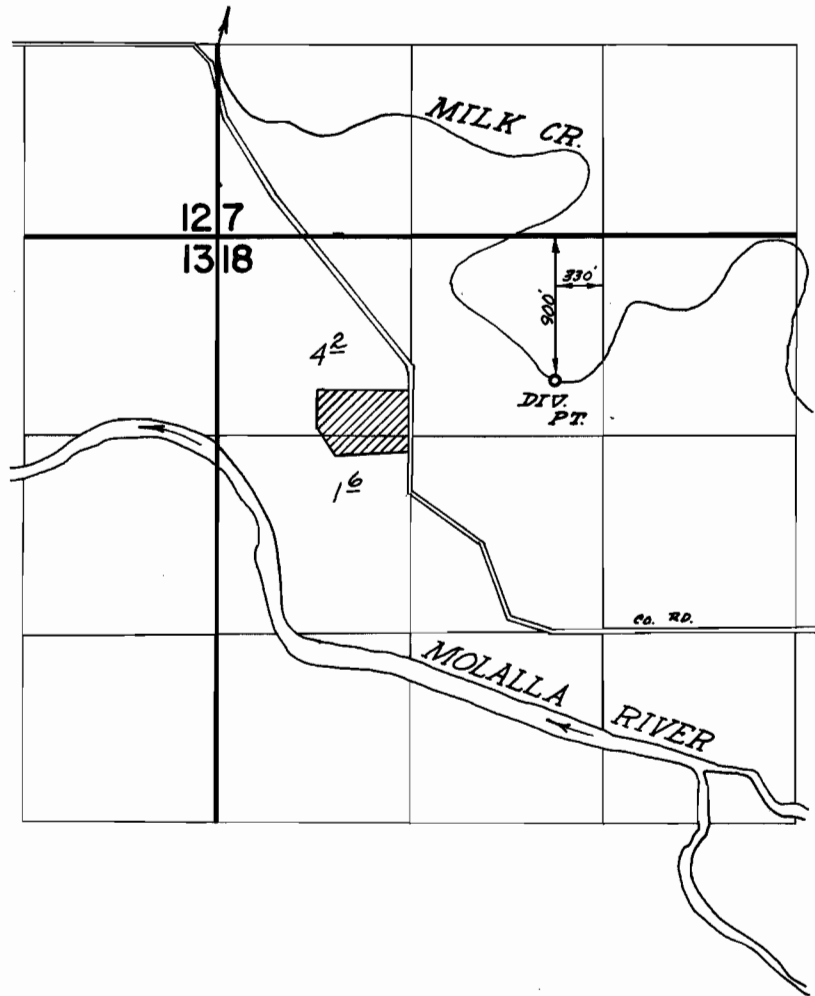

**FINAL PROOF SURVEY**  
UNDER

Application No. 49881 Permit No. 36949  
IN NAME OF

ROBERT ALBER

Surveyed Sept. 4 1974, by D. Norby