


T.3 N. R.2 W. W.M.

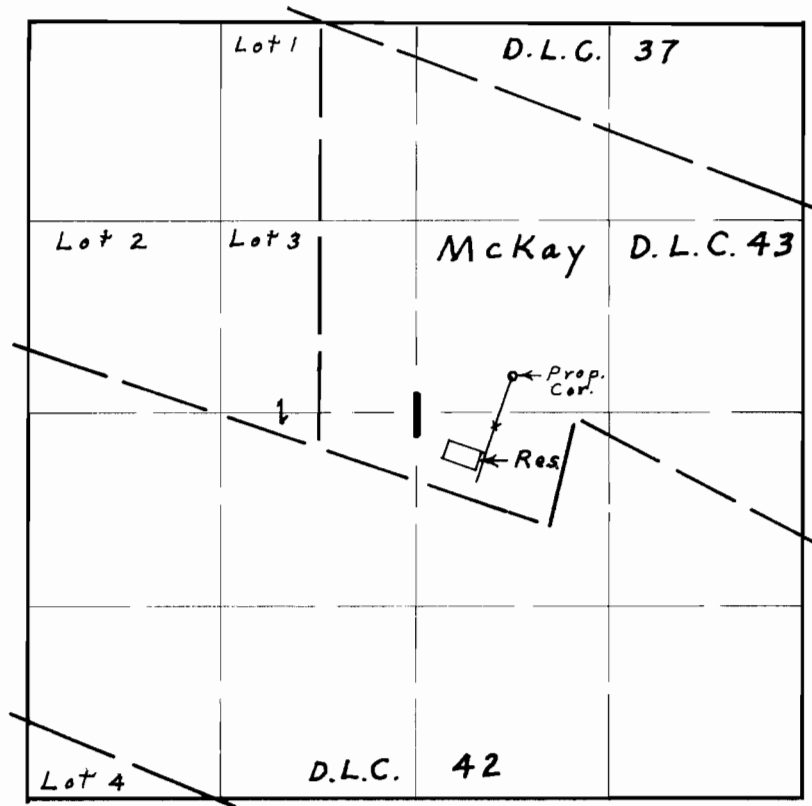

FINAL PROOF SURVEY
UNDER

R-44544 R-5130
Application No. 44545 Permit No. 33118

IN NAME OF

JOHNIE WOOD

Surveyed June 28 1974, by L. E. Gould