


T.5 N. R.2 W. W.M.

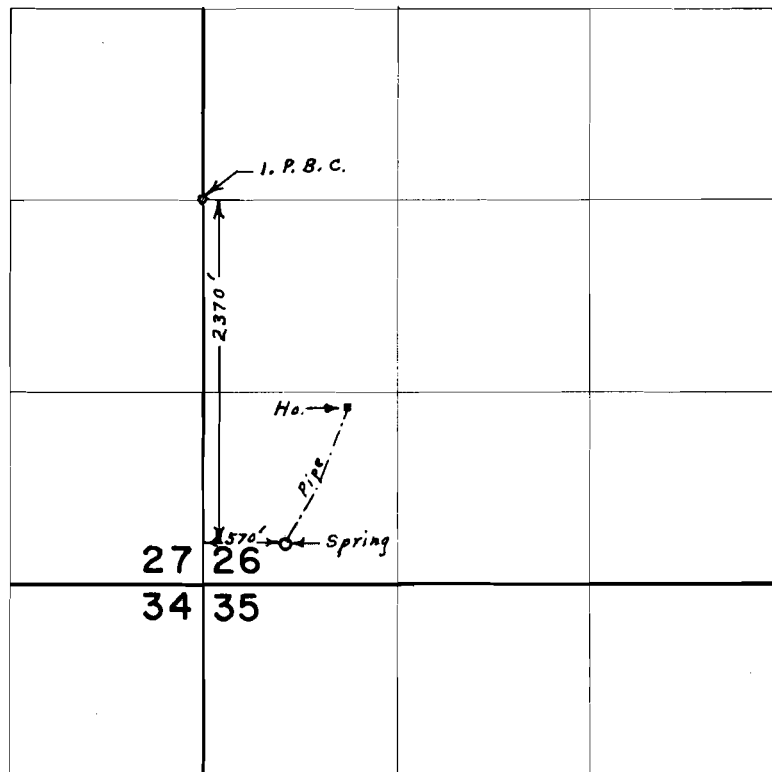

FINAL PROOF SURVEY
UNDER

Application No. 47239 Permit No. 34884
IN NAME OF

HOMER W. & LELA B. HARRISON

Surveyed June 24, 1974, by L. E. Gould