


T. 4 N. R. 1 W. W.M.

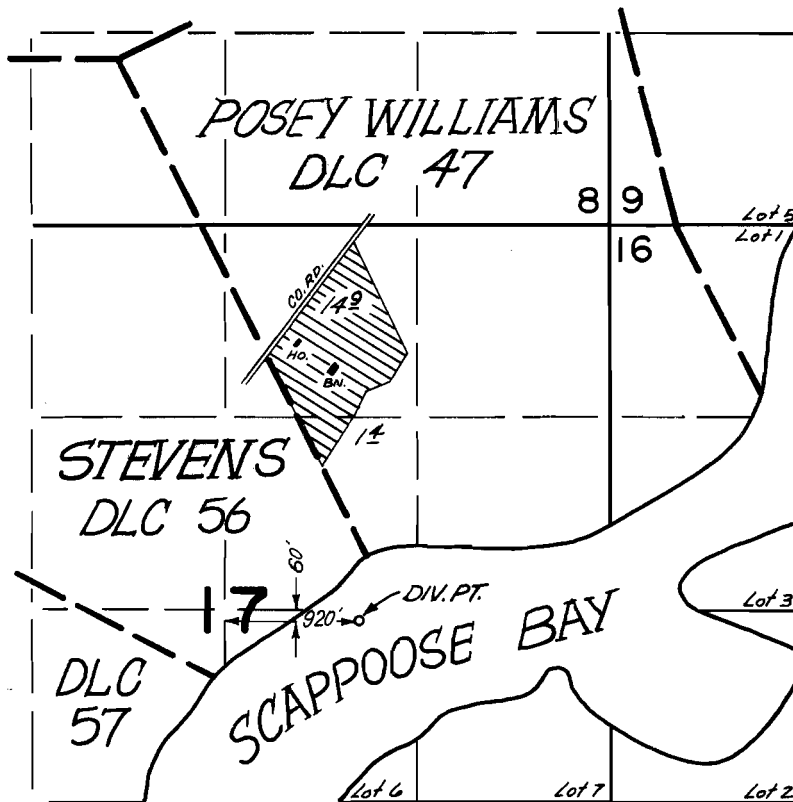

FINAL PROOF SURVEY UNDER

Application No. 50177 Permit No. 36952
IN NAME OF

VON N. & IDA L. SMITH

Surveyed JUNE 13 1975, by R.G. MUCKEN