


# T.25S. R.11W. W.M.

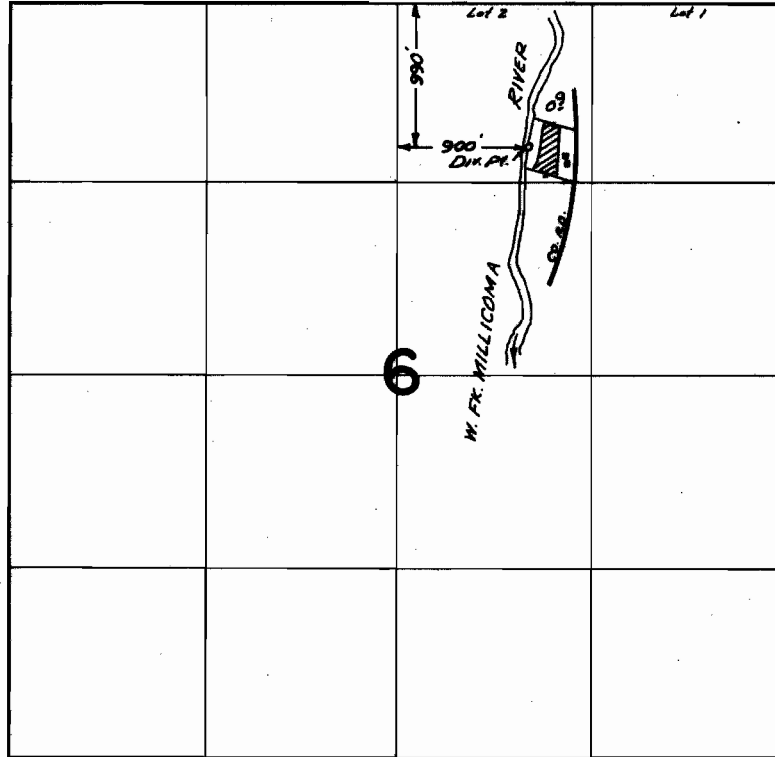

## FINAL PROOF SURVEY UNDER

Application No. 47497 Permit No. 35574  
IN NAME OF

BRUCE & CYNTHIA MORRIS

Surveyed AUG. 2, 1972, by R.S. MUCKER