


T.41S.,R.13W.,W.M.

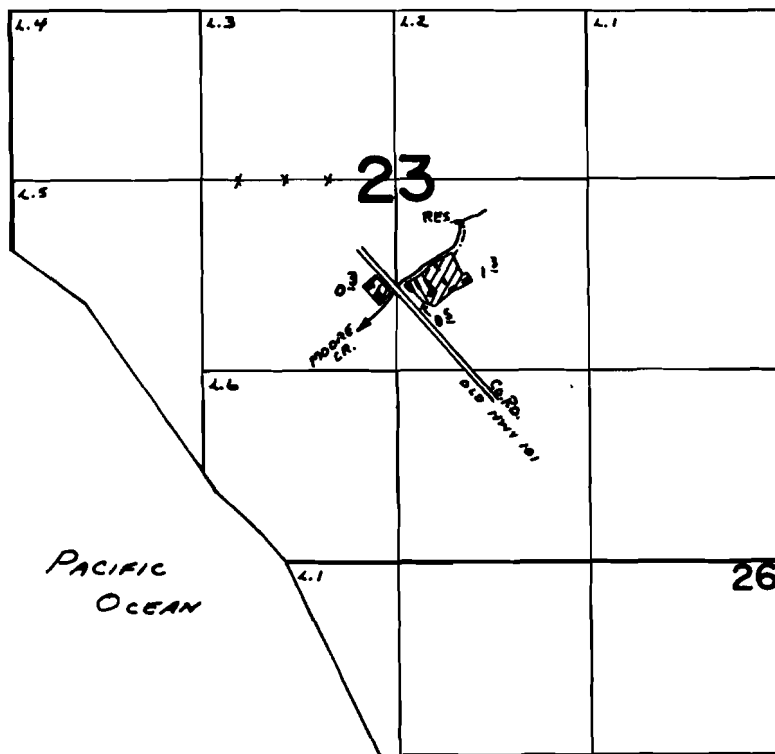

□ - DWELLING
▨ - PRIMARY
- SUPPLEMENTAL TO CERT. 32422
RES. Loc: 300'S 1/4 & 400'E FROM C 1/4 COR. SEC. 23

FINAL PROOF SURVEY UNDER

Application No. R-46390 46344 Permit No. R-5477 34401
IN NAME OF

OTTO C. & MARJORIE R. TURLEY

Surveyed JULY 18 1975 by L. Tall