


T.4S.,R.13W.,W.M.

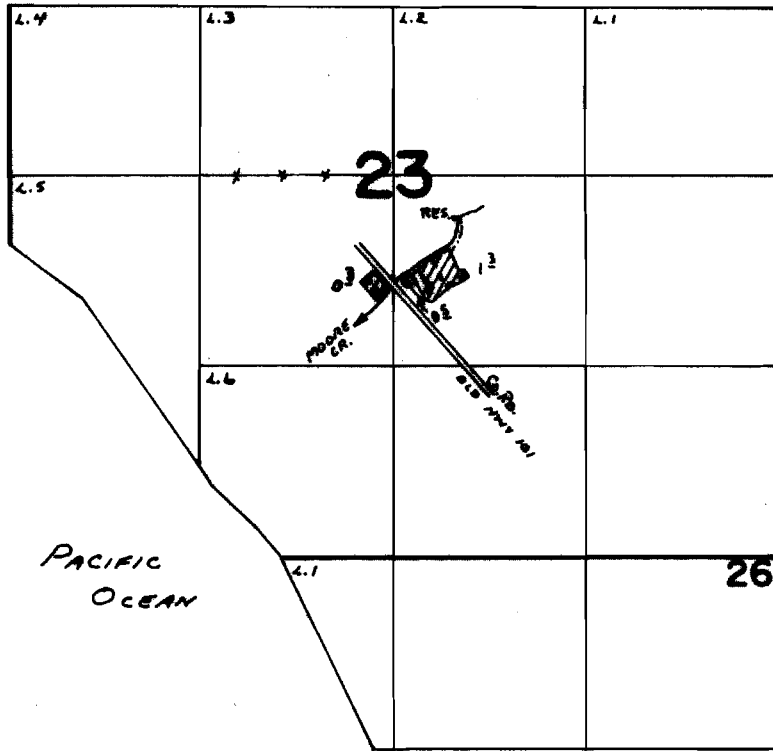

D - DWELLING
 PRIMARY
 SUPPLEMENTAL TO CERT. 32422
 Res. Loc: 300'S 1/4 440'E FROM C 1/4 COR. SEC. 23

FINAL PROOF SURVEY UNDER

Application No. R-46390 Permit No. R-5477
46344 34401
 IN NAME OF

OTTO C. B. MARJORIE R. TURLEY

Surveyed July 18, 1975 by L. Tall