


T.22S.R.7W.W.M.

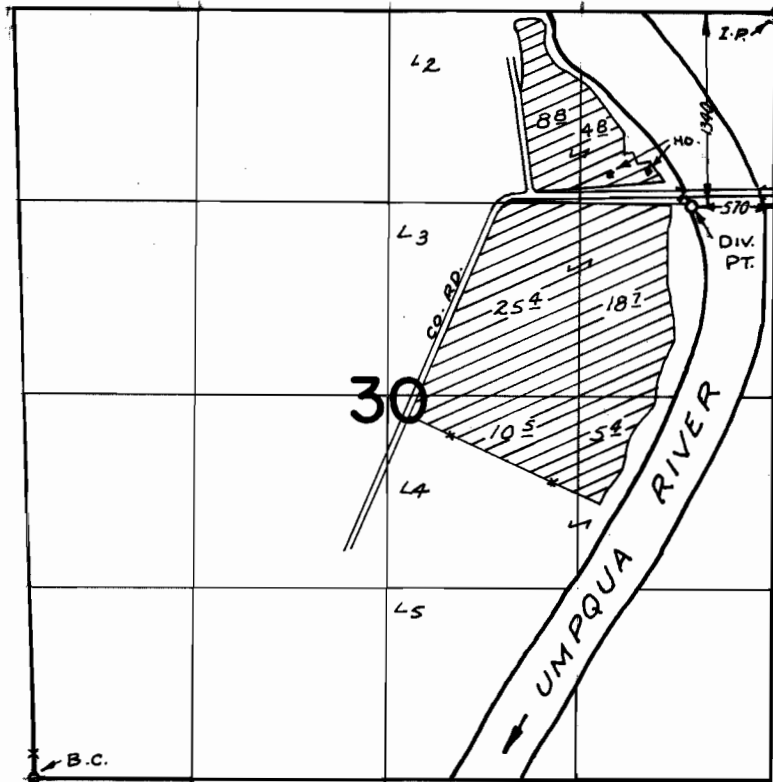

FINAL PROOF SURVEY
UNDER

Application No. 42245 Permit No. 31610
IN NAME OF

PHILIP BECKLEY & LARRY THOMAS

Surveyed APR. 30, 1974, by R. MUCKEN