


T.25S.R.4W.W.M.

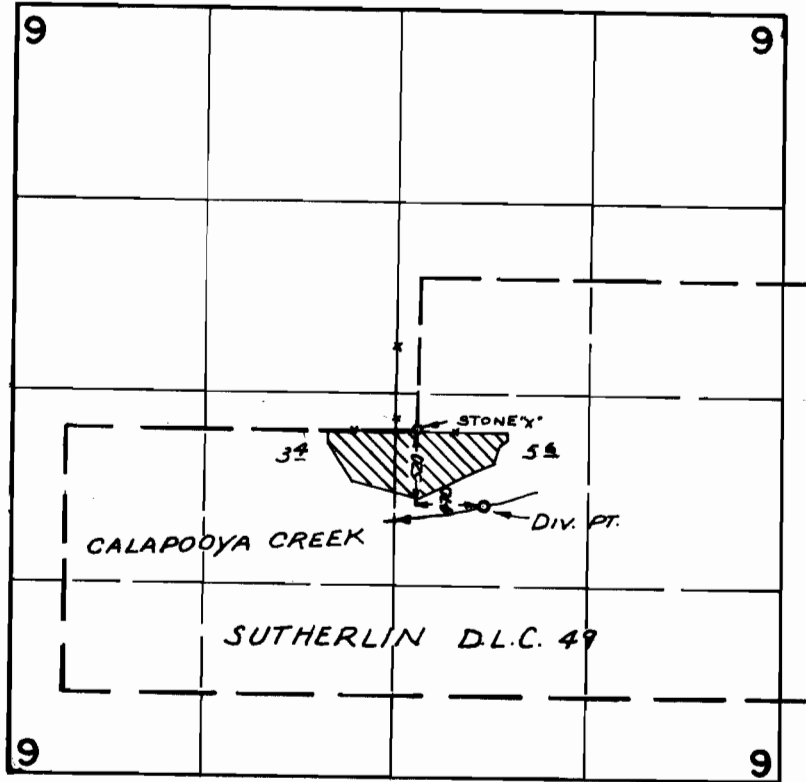

FINAL PROOF SURVEY
UNDER

Application No. 45900 Permit No. 34275
IN NAME OF

JOAN WILKINS

Surveyed OCT. 15, 1974, by R. MUCKEN