


T. 26 S. R. 7 W. W.M.

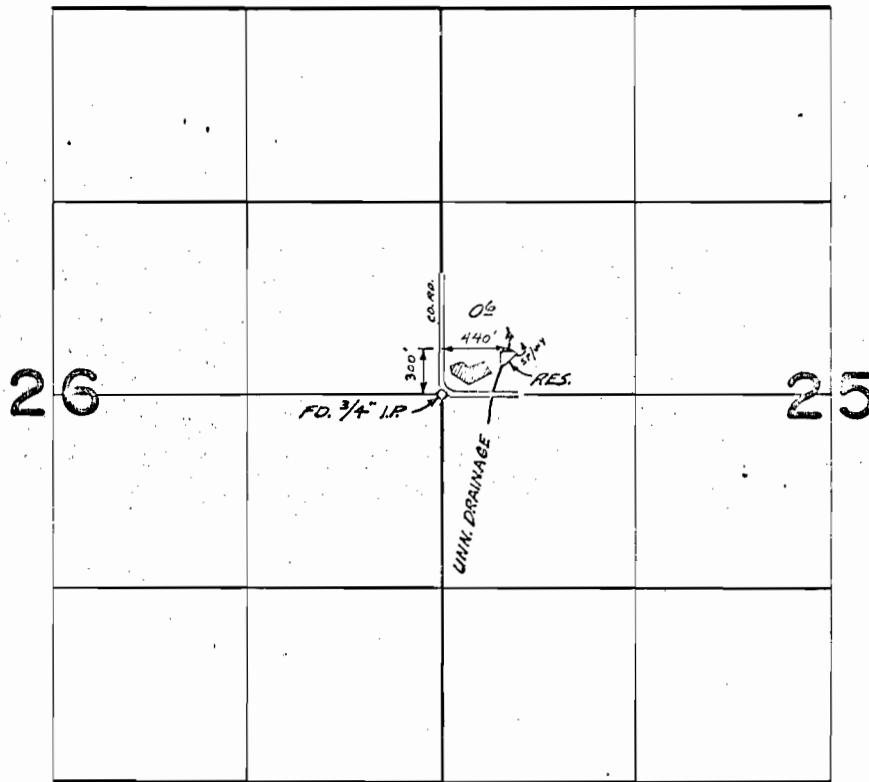

FINAL PROOF SURVEY
UNDER

Application No. *R-47787* ~~47735~~ Permit No. *R-5770* ~~35757~~
IN NAME OF

Robert E. Rocheleau

Surveyed *AUGUST 22 1974* by *L.M. TOLL*