


T. 26 S. R. 7 W. W.M.

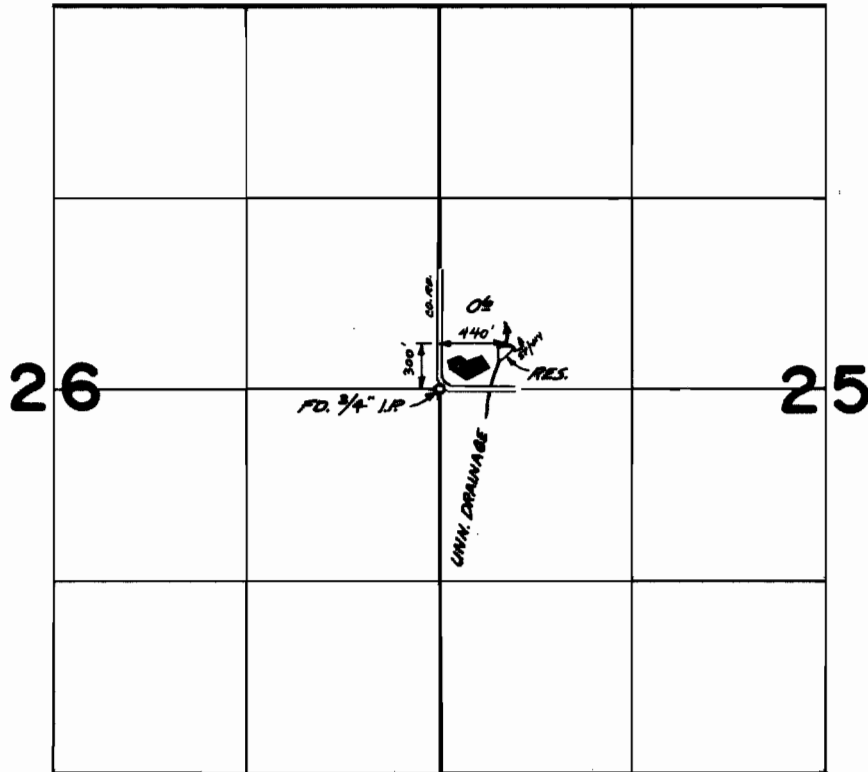

**FINAL PROOF SURVEY**  
UNDER

R-47787                      R-5770  
Application No. 47735      Permit No. 35757  
IN NAME OF

Robert E. Rocheleau

Surveyed AUGUST 22 1974, by L.M. TOLL