


T.26S. R.6W. W.M.

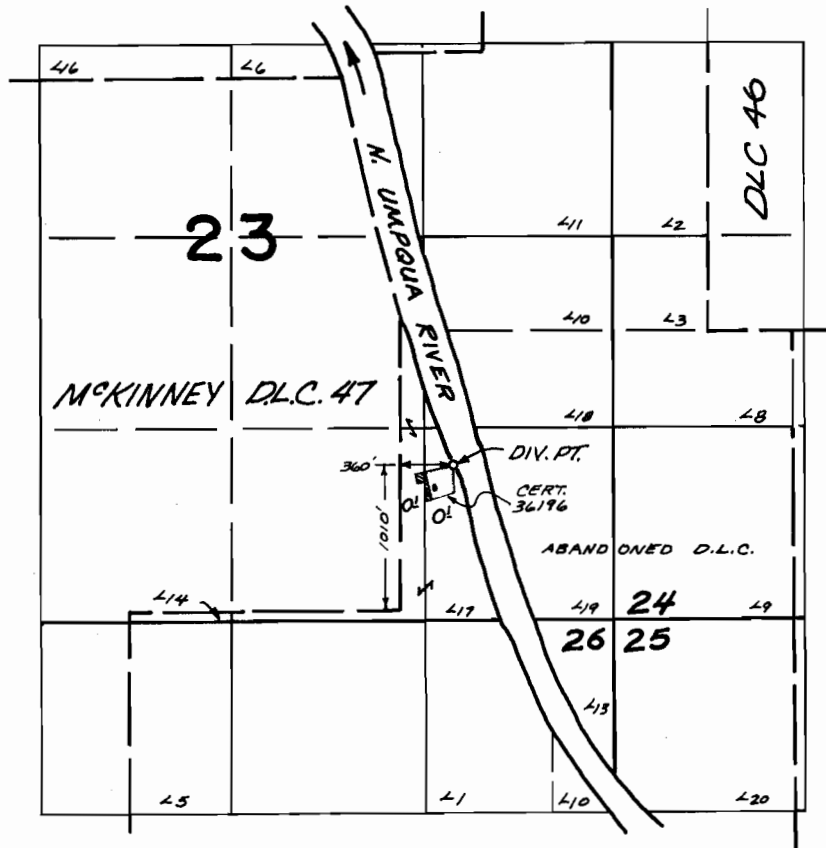

FINAL PROOF SURVEY UNDER

Application No. 48274 Permit No. 36257
IN NAME OF

WALTER F. BAMMANN

Surveyed JUNE 18 1974, by L.M. TOLL