


T.35&36S.R.2 W. W.M.

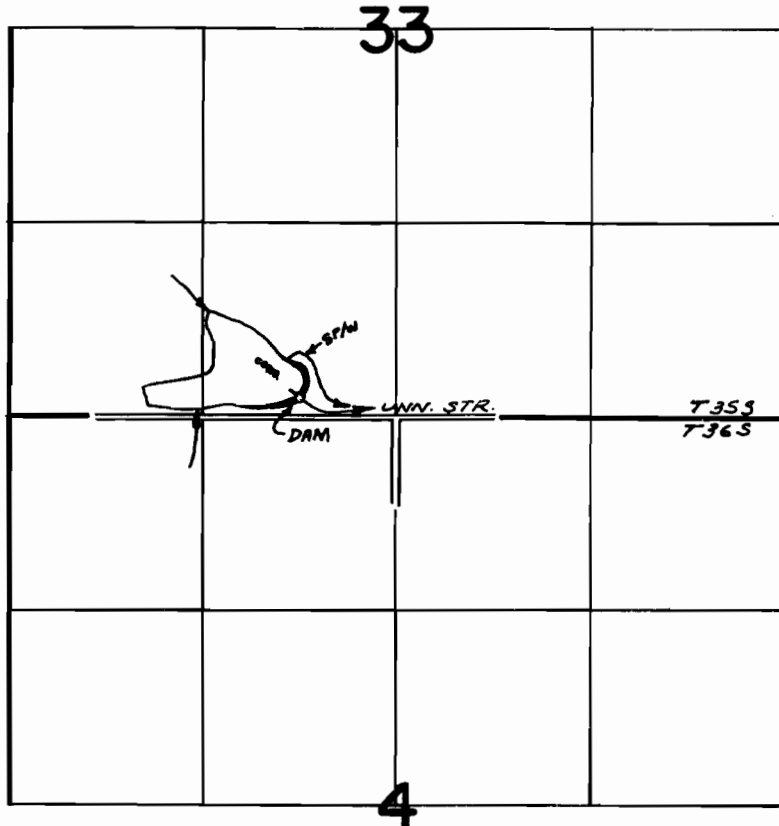

DAM 130' N. & 640' W. FROM S<sup>1</sup>/<sub>4</sub> COR. SEC. 33

**FINAL PROOF SURVEY**  
UNDER

R-44371                      R-5140  
Application No. 44372      Permit No. 33146  
IN NAME OF

FRANCIS CHENEY

Surveyed OCT. 16, 1973, by R.G. MUCKEN