


T.35&36S.R.2 W. W.M.

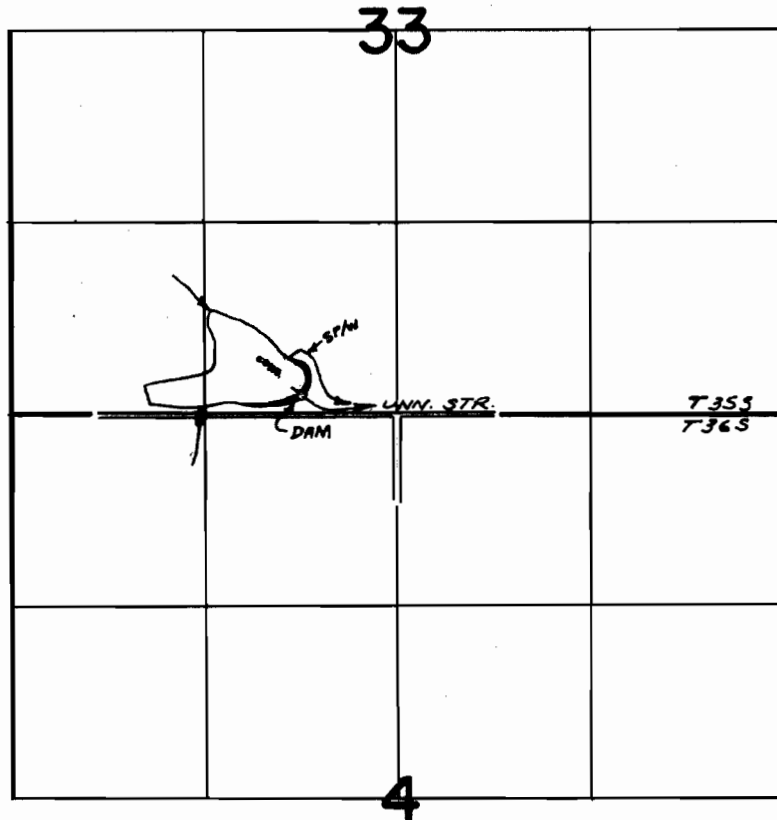

DAM 130' N. & 640' W. FROM S¹/₄ COR. SEC. 33

FINAL PROOF SURVEY
UNDER

Application No. R-44371 44372 Permit No. R-5140 33146
IN NAME OF

FRANCIS CHENEY

Surveyed OCT. 16 19.73, by R.G. MUCKEN