


T.33&34S.R.6W.W.M.

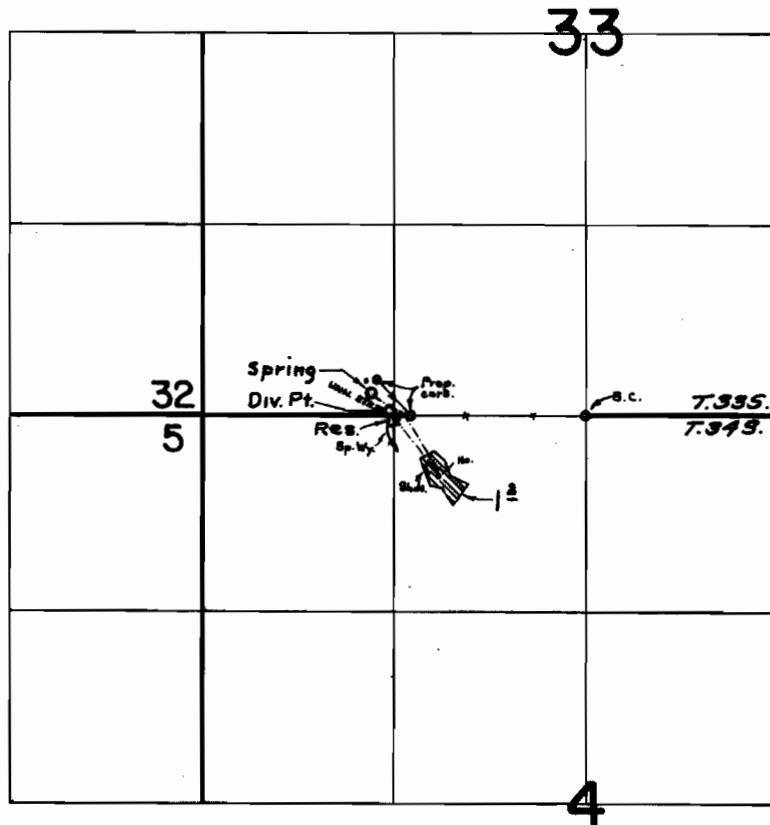

Spring located: 150' N. & 1470' W., Div. Pt. from Unn. Str. located 30' N. & 1350' W.
both from S. 1/4 cor. Sec. 33

FINAL PROOF SURVEY
UNDER

Application No. 48900 Permit No. 36630
R-49047 R-5939
IN NAME OF

LESLIE G. & VERA L. ESPE

Surveyed MAY 24, 1974, by L.E. GOULD