


T.37 S. R.6 W. W.M.

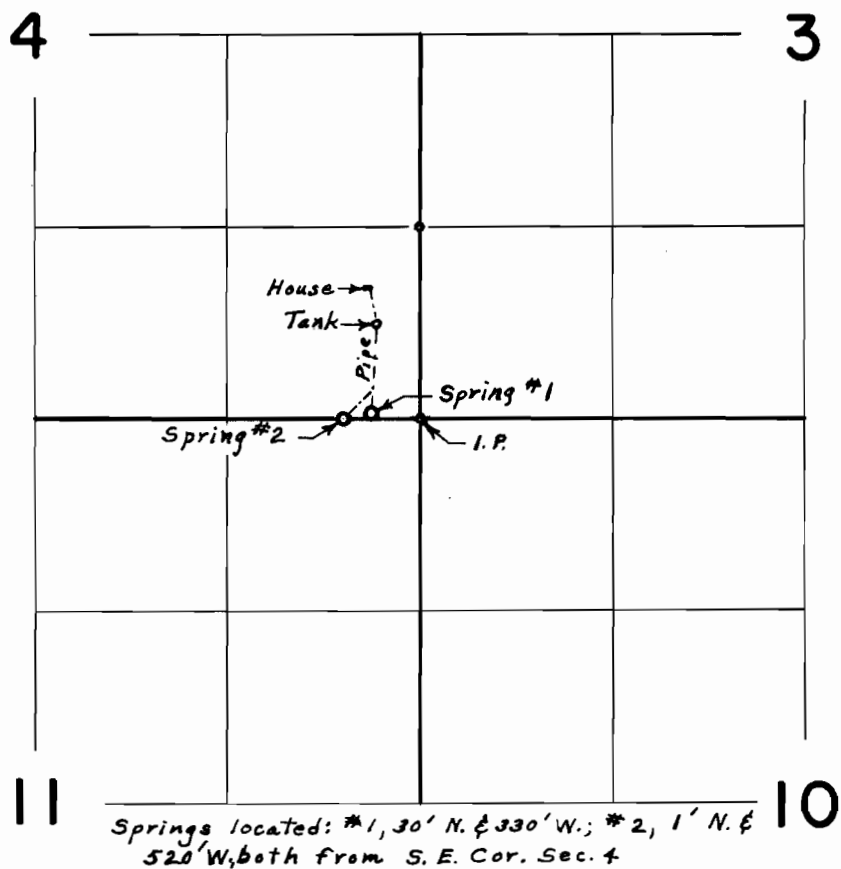

FINAL PROOF SURVEY
UNDER

Application No. 50884 Permit No. 37388
IN NAME OF

THOMAS RALPH COVENEY JR.

Surveyed May 12, 1975, by L. E. Gould