30381
42936

T. 34 S. R. 7 1/2 E. W.M.

EAST of WOOD RIVER

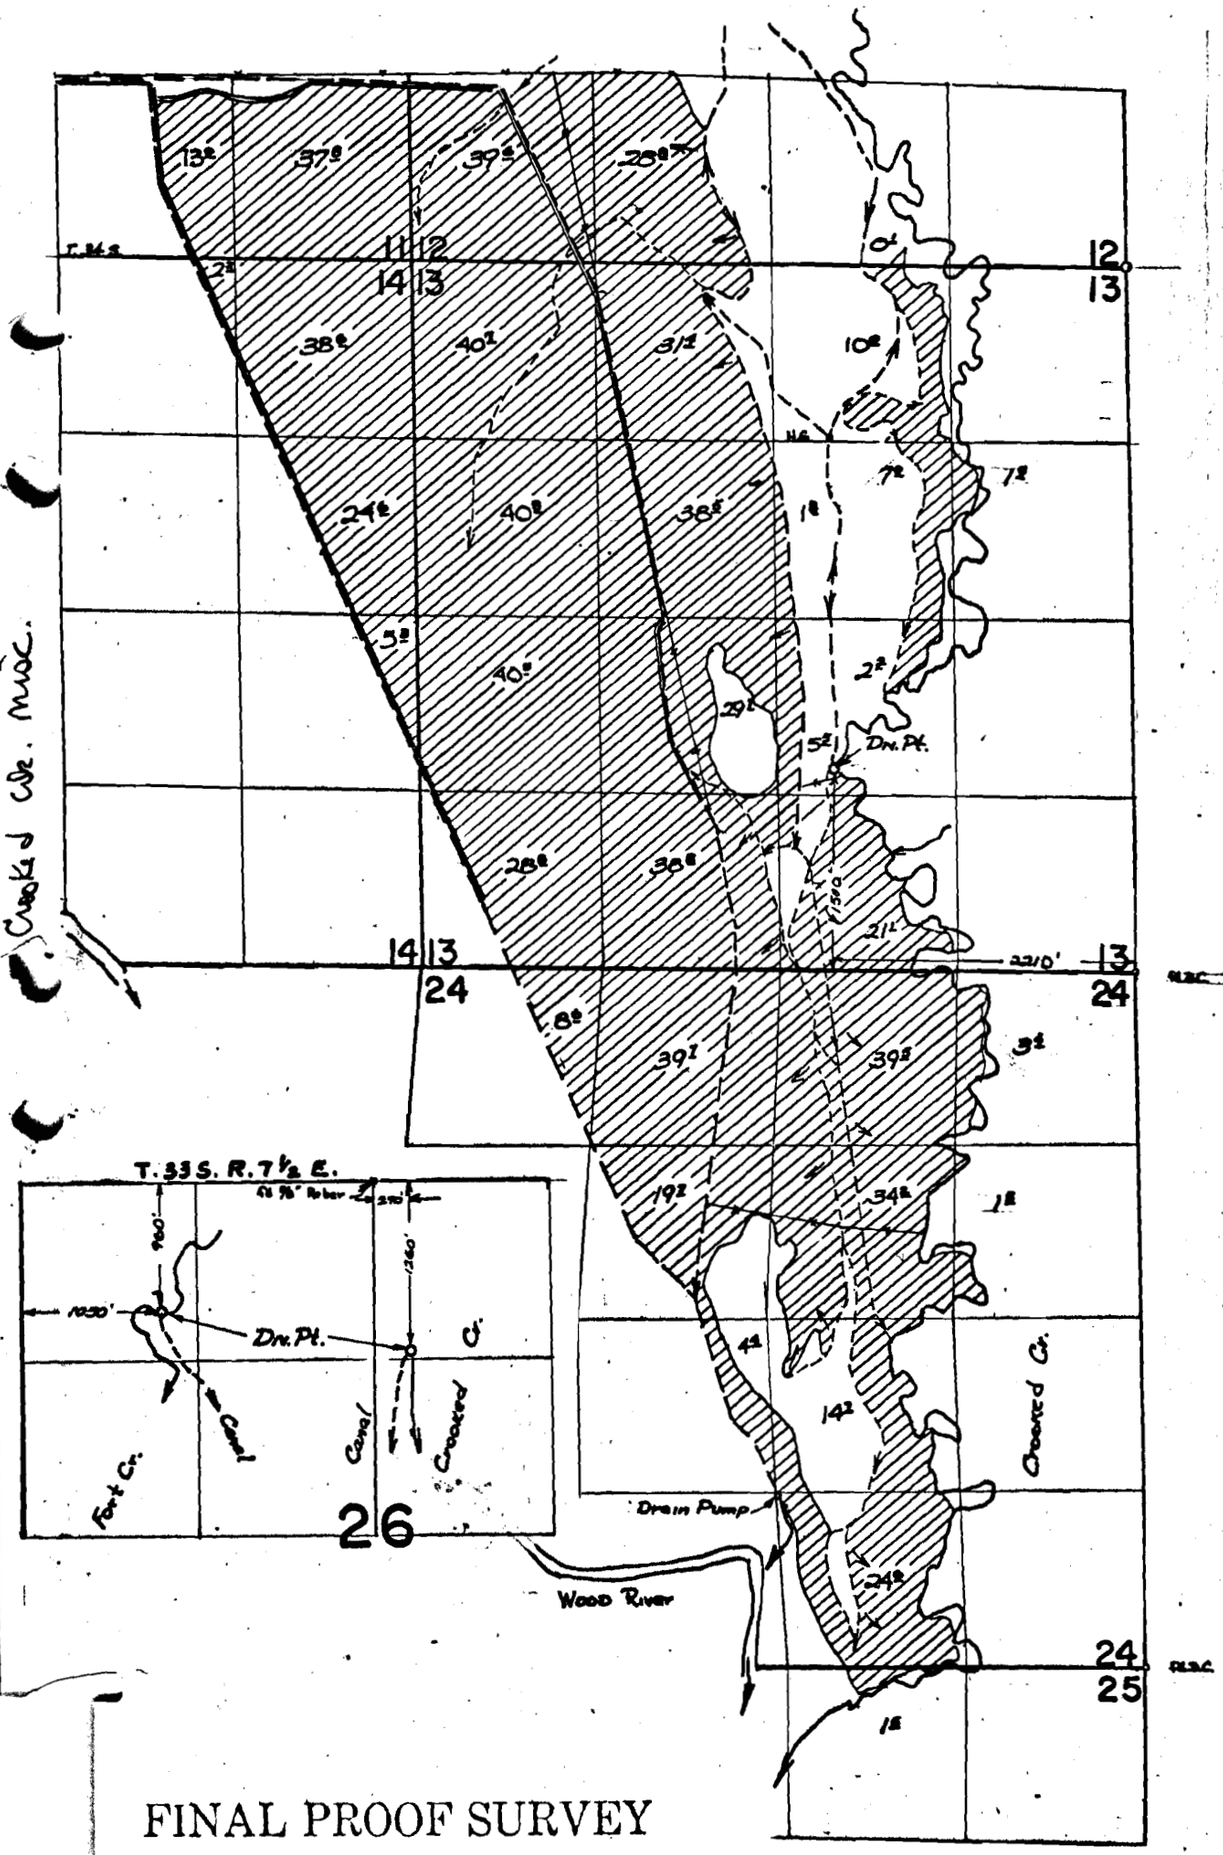

FINAL PROOF SURVEY

UNDER

Application No. 40754 Permit No. 30381

IN NAME OF

NATIONAL BANK OF PORTLAND, Trustee

Surveyed 12 MAY 1970, by D. R. BUELL