


T.20S. R.3W. W.M.

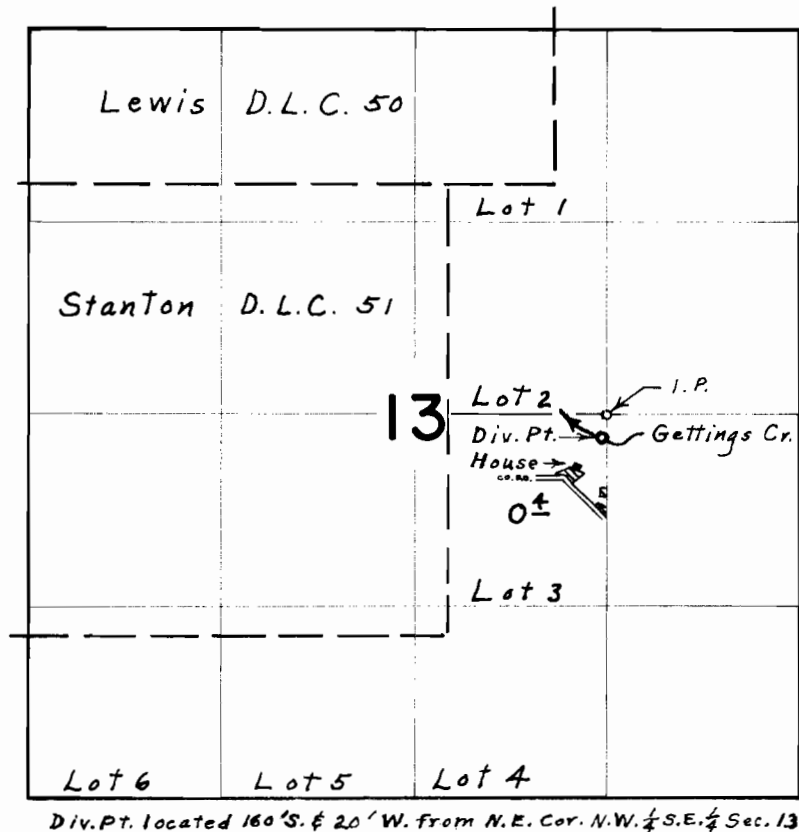

FINAL PROOF SURVEY
UNDER

Application No. 49085 Permit No. 36721
IN NAME OF

TERRY WAYNE COSS

Surveyed March 26, 1975, by L. E. Gould