


T.13S. R.11W. W.M.

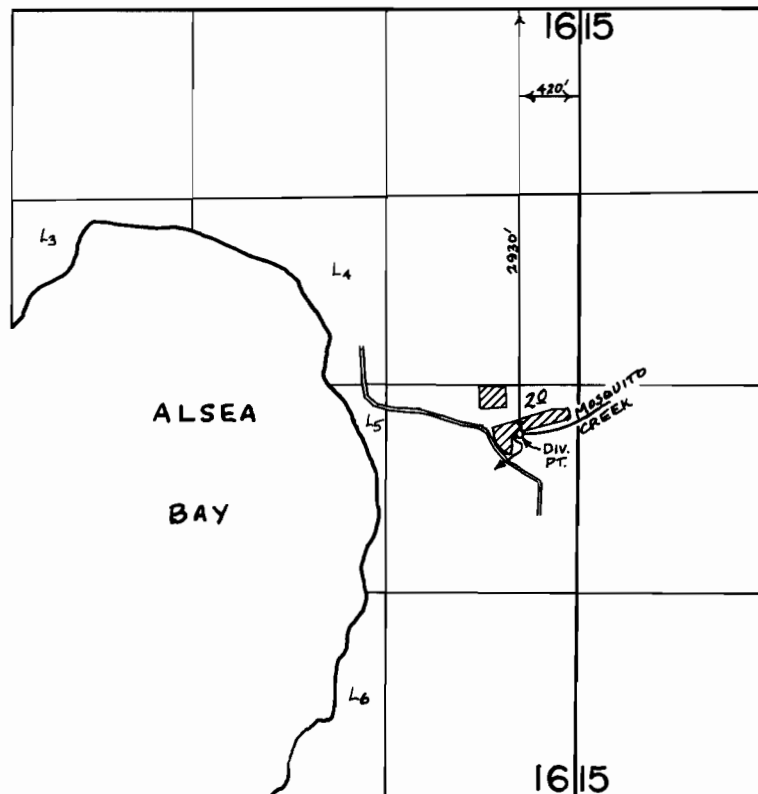

FINAL PROOF SURVEY
UNDER

Application No. 48764 Permit No. 36572
IN NAME OF

CHRIS & EDWARD KILIAN

Surveyed AUG. 20 1974 by D. NORBY