


T.13S. R.10W. W.M.

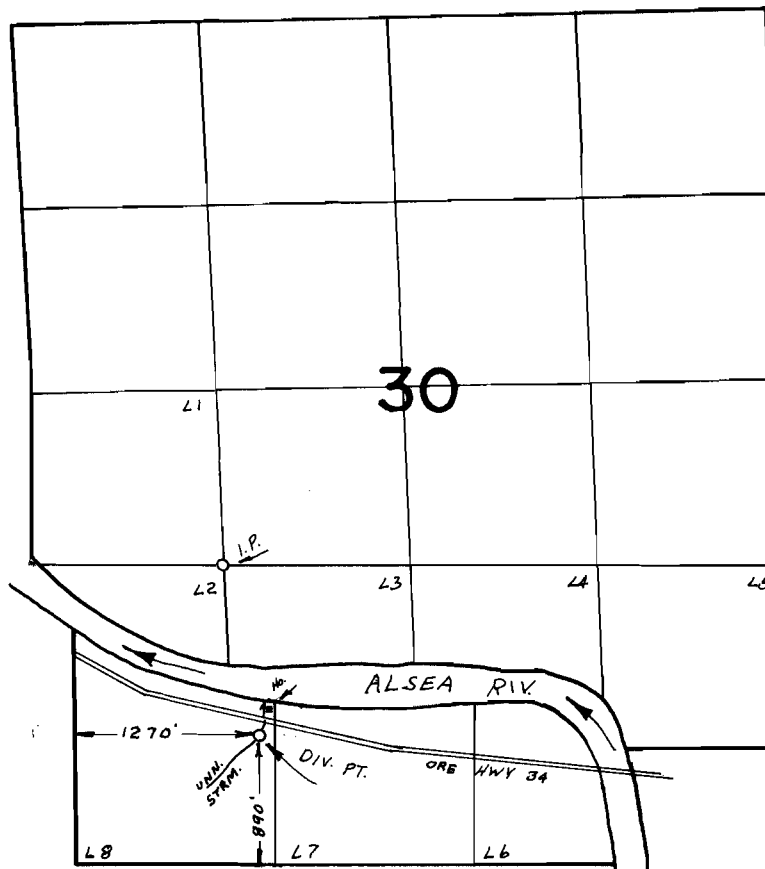

FINAL PROOF SURVEY
UNDER

Application No. 43405 Permit No. 32454
IN NAME OF

C. E. YOST

Surveyed JUN 6 1974, by L H NUNN