


T.13S, R.10W. W.M.

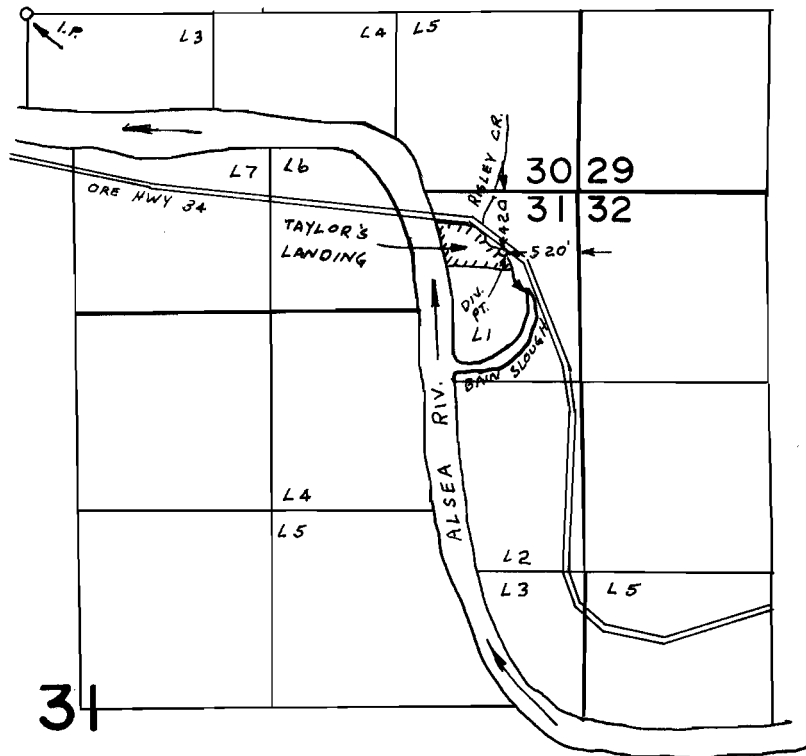

FINAL PROOF SURVEY
UNDER

Application No. 43650 Permit No. 32630

IN NAME OF

ELMER CHAMBERS

Surveyed JUN 6 1974, by L.H. NUNN