


T.10&11S. R.8W. W.M.

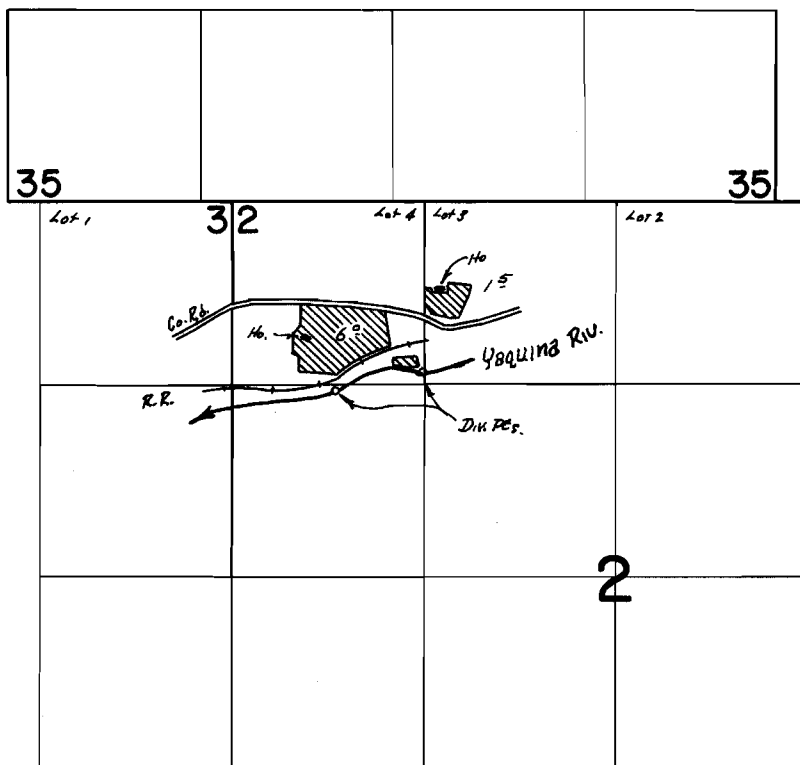

Div. Pcs LOC: 1300'S & 700'E; 1170'S & 1300'E BOTH FROM NW COR SEC. 2

FINAL PROOF SURVEY
UNDER

Application No. 44044 Permit No. 32915....
IN NAME OF

W. E. FORSTER

Surveyed Aug. 29 1974, by R. G. MUCKEN