


T.13S. R.11W. W.M.

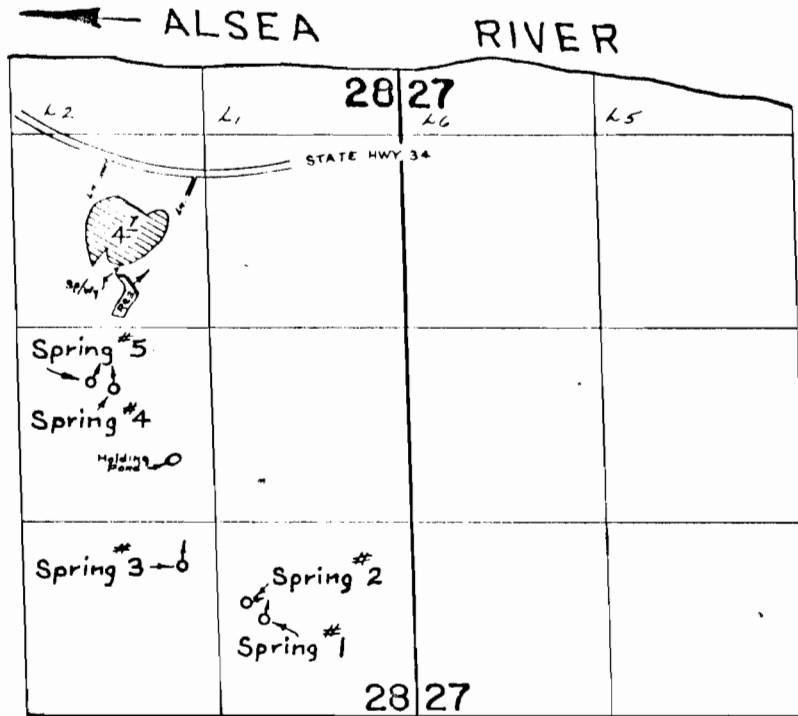

SPRINGS LOCATED: #1 - 865' N. & 1035' W.; #2 - 770' N. & 1150' W.; #3 - 1015' N. & 1600' W.; #4 - 2215' N. & 2045' W.; #5 - 2255' N. & 2205' W. FROM THE SOUTHEAST CORNER SECTION 28
 DAM LOCATED: 2900' N. & 1930' W. FROM SOUTHEAST CORNER SECTION 28

FINAL PROOF SURVEY UNDER

Application No. 46006 Permit No. 34336
R-46005 R-5471
 IN NAME OF

WILLARD W. THOMPSON, SR.

Surveyed AUG. 19, 1974, by O. NORBY