


T.9S.R.11W.W.M.

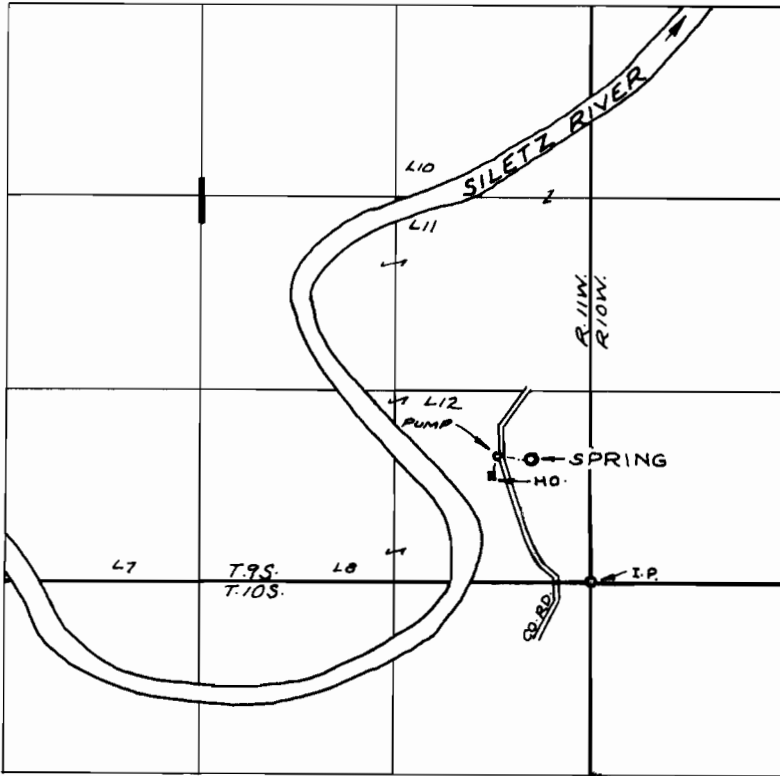

FINAL PROOF SURVEY
UNDER

Application No. 46093..... Permit No. 34441.....
IN NAME OF

RACHEL STROME CRITESER

Surveyed AUG. 27, 1974, by R. MUGKEN.....