


# T.6S. R.10W. W.M.

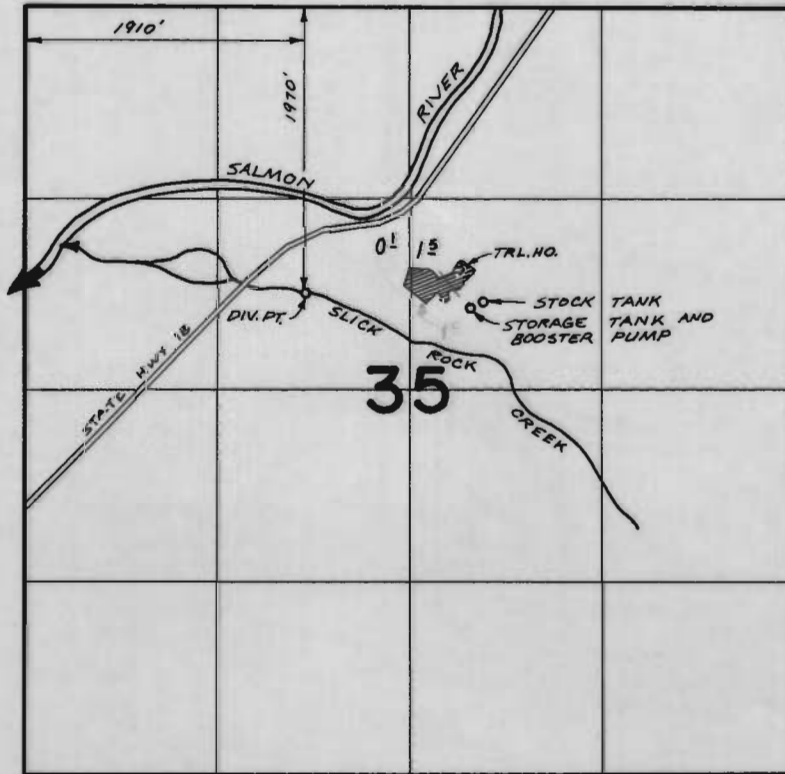

## FINAL PROOF SURVEY UNDER

Application No. 48125 Permit No. 35499  
IN NAME OF

FRANCIS L. WRIGHT

Surveyed JULY 18 1974, by D. NORBY