


T.17S. R.47E. W.M.

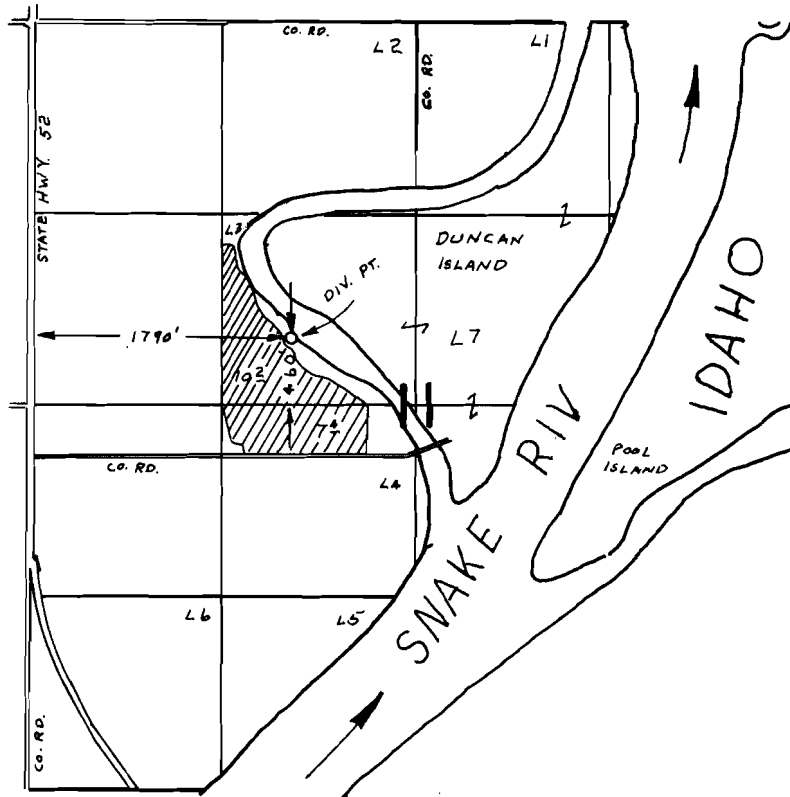

FINAL PROOF SURVEY
UNDER

Application No. 46442 Permit No. 34701
IN NAME OF

LOUIS A. GOFF

Surveyed JUN 18 1974, by LH NUNN