T.4 S. R.2 W. W.M.

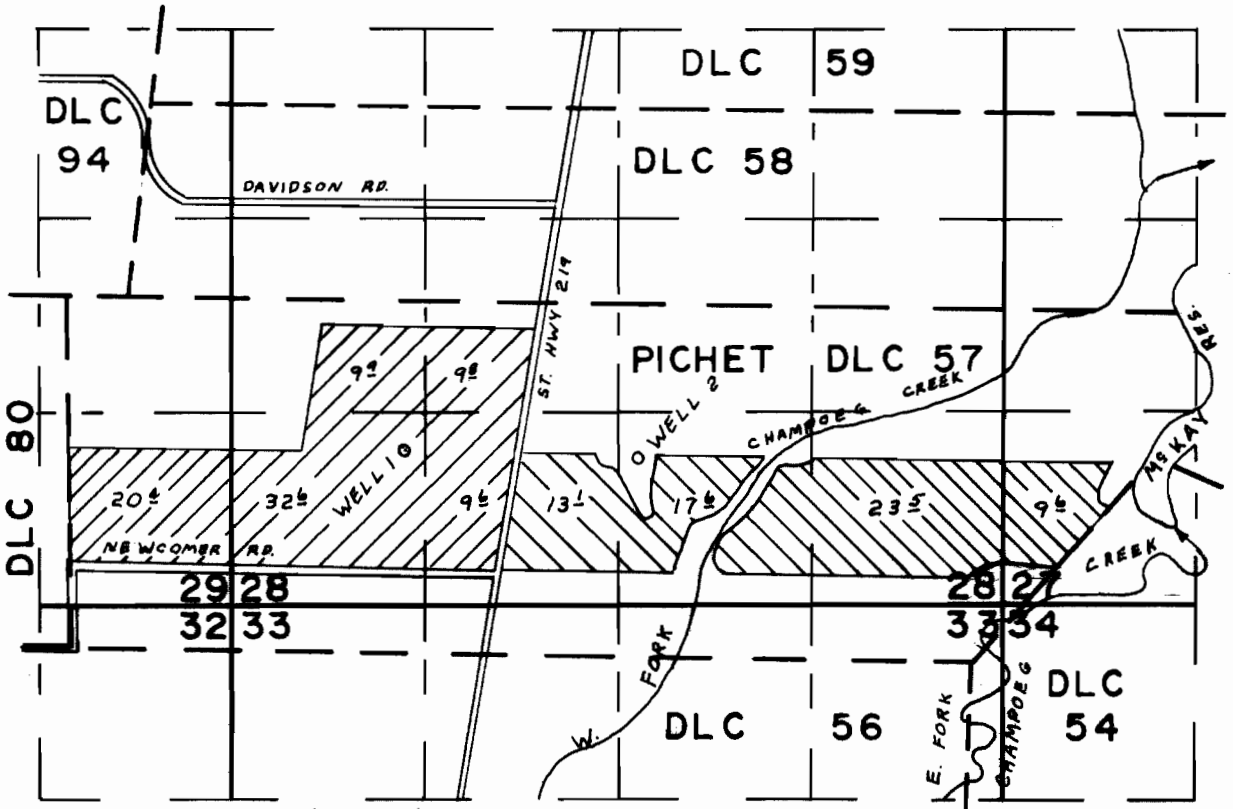

WELL 1 - 1340' N & 2300' E, WELL 2 - 1270' N & 3900' E, BOTH FROM THE SW COR., PICHET LLC 57

FINAL PROOF SURVEY
UNDER

Application No. G-4925 Permit No. G-4641
IN NAME OF

Philip Wolfe

Surveyed MAY 24 1973, by T. PAUL

DFN-5LL-256 LHN