


T.8S. R.1E. W.M.

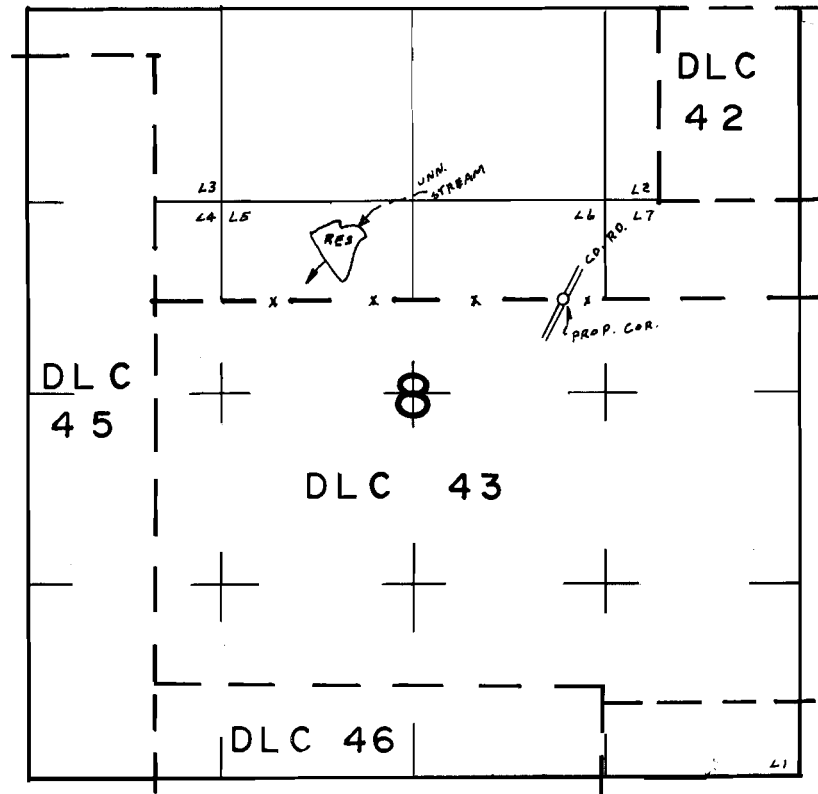

FINAL PROOF SURVEY
UNDER

Application No. R-49299 Permit No. R-6003
IN NAME OF

ARCHIE GARDNER

Surveyed MAY 30 1974, by L.H. NUNN