T.8S. R.2W. W.M.

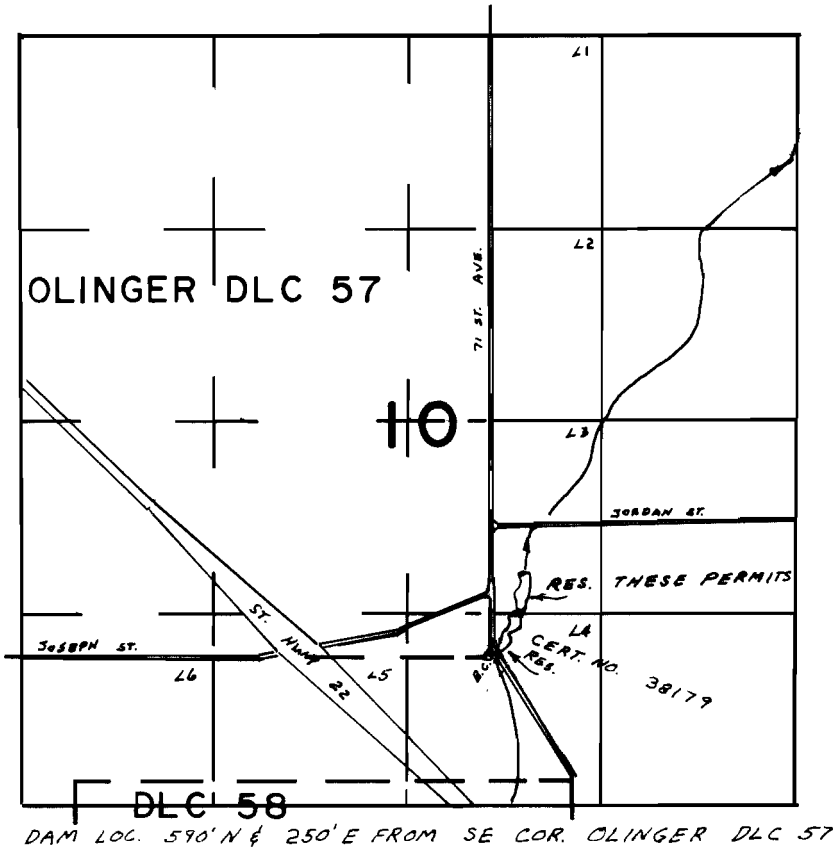

FINAL PROOF SURVEY
UNDER

Application No. R-45449 (45450) Permit No. R-5353 (33841)
IN NAME OF

GORDON D. WOODS

Surveyed JUL 1 1974, by L.H. NUNN

1974-R LHN